
# PARCEL A, DISTRICT LOT 97, GROUP 1, NEW WSETMINSTER PLAN BCP23739 5756 IMPERIAL STREET, BURNABY, BC

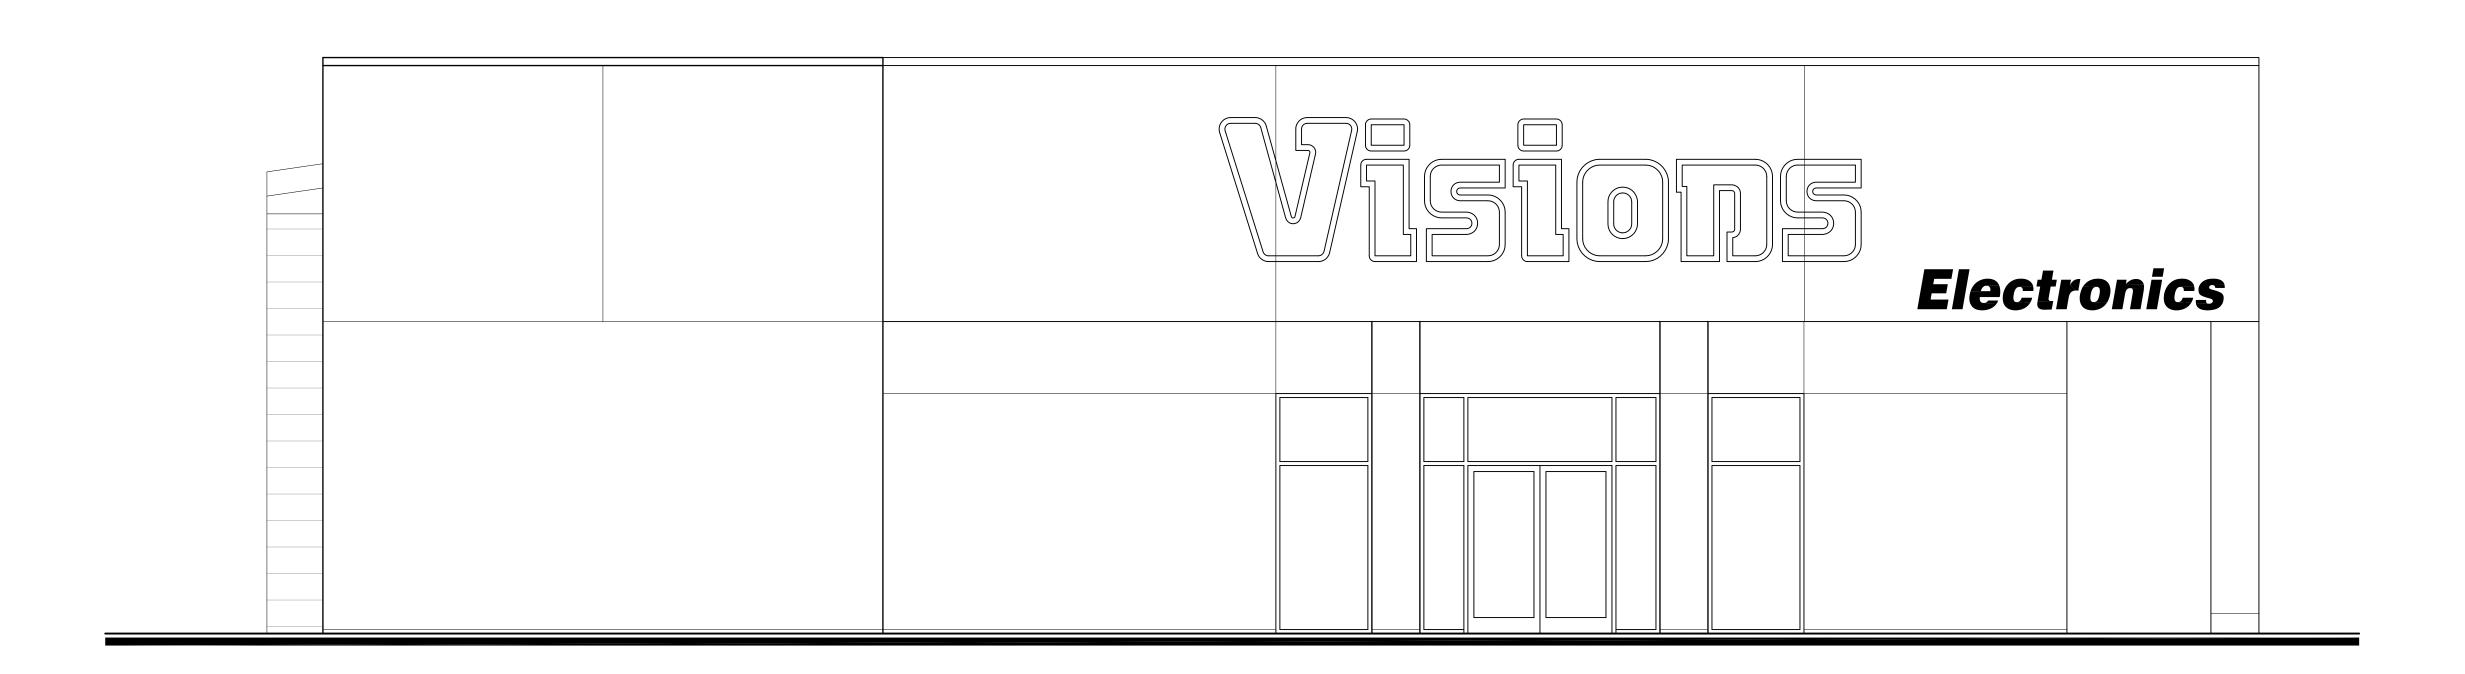

#### DRAWING LIST:

ARCHITECTURAL

PJ LOVICK ARCHITECT LTD. 3707 1st AVENUE, BURNABY, B.C., V5C 3V6 (tel) 604.298.3700 (fax) 604.298.6081 (e-mail) pjlovick@pjlovick.com

A0 COVER SHEET
AS1 SITE PLAN

AS2 SITE DETAILS

A1 DEMOLITION FLOOR PLAN

A2 PROPOSED MAIN FLOOR PLAN & EXISTING MEZZANINE PLAN

A3 PROPOSED MAIN FLOOR REFLECTED CEILING PLAN

A4 EXISTING ROOF PLAN

A5 EXISTING / PROPOSED
NORTH / SOUTH BUILDING ELEVATIONS

A10 WALL SECTIONS

A11 WALL SECTIONS

A12 SECTION DETAILS

A13 SECTION DETAILS

A14 SECTION DETAILS

A6 EXISTING / PROPOSED

EAST / WEST BUILDING F

EAST / WEST BUILDING ELEVATIONS

A7 BUILDING SECTIONS

A8 DOOR / WINDOW SCHEDULE

A9 ROOM FINISH SCHEDULE

### STRUCTURAL

BEVAN PRITCHARD MAN 210 - 195 WEST 2nd Ave, VANCOUVER, B.C, V5Y 1B8 (tel) 604.688.3244 (fax) 604.684.9964 (e-mail) gbp\_bpm@telus.net

S1.1 GENERAL NOTES

S2.1 GENERAL NOTES

S3.1 GROUND FLOOR PLAN AND MEZZANINE PLAN AND PARTIAL ROOF PLAN

S3.2 ROOF PLAN

S4.1 NORTH & SOUTH ELEVATIONS

S4.2 EAST & WEST ELEVATIONS

#### **MECHANICAL**

DEC ENGINEERING 309 - 713 COLUMBIA STREET, NEW WESTMINSTER, B.C, V3M 1B2 (tel) 604.525.3341 (fax) -

(e-mail) drawings@decmail.ca

M1 MAIN FLOOR & MEZZANINE HVAC

M2 ROOF PLAN HVAC

M3 DETAILS HVAC

M3 SPECIFICATIONS, SCHEDULES HVAC

### ELECTRICAL

SEB CONSULTANTS LTD 310-7377 SALISBURY AVE, BURNABY, BC, V5E 4B2 (tel) 604.526.8953 (mob) 778.727.5206 (e-mail) sebconsultants@shaw.ie


E1 LIGHTING PLAN E2 POWER PLAN


E2 SPECIFICATION & SYMBOLS


#### LANDSCAPE


PMG LANDSCAPE ARCHITECTS LTD. C100 4185 STILL CREEK DRIVE, BURNABY, B.C., V5C 6G9 (tel) 604.294.0011 (fax) 604.294.0022


L1 LANDSCAPE PLAN & PLANT SCHDULE

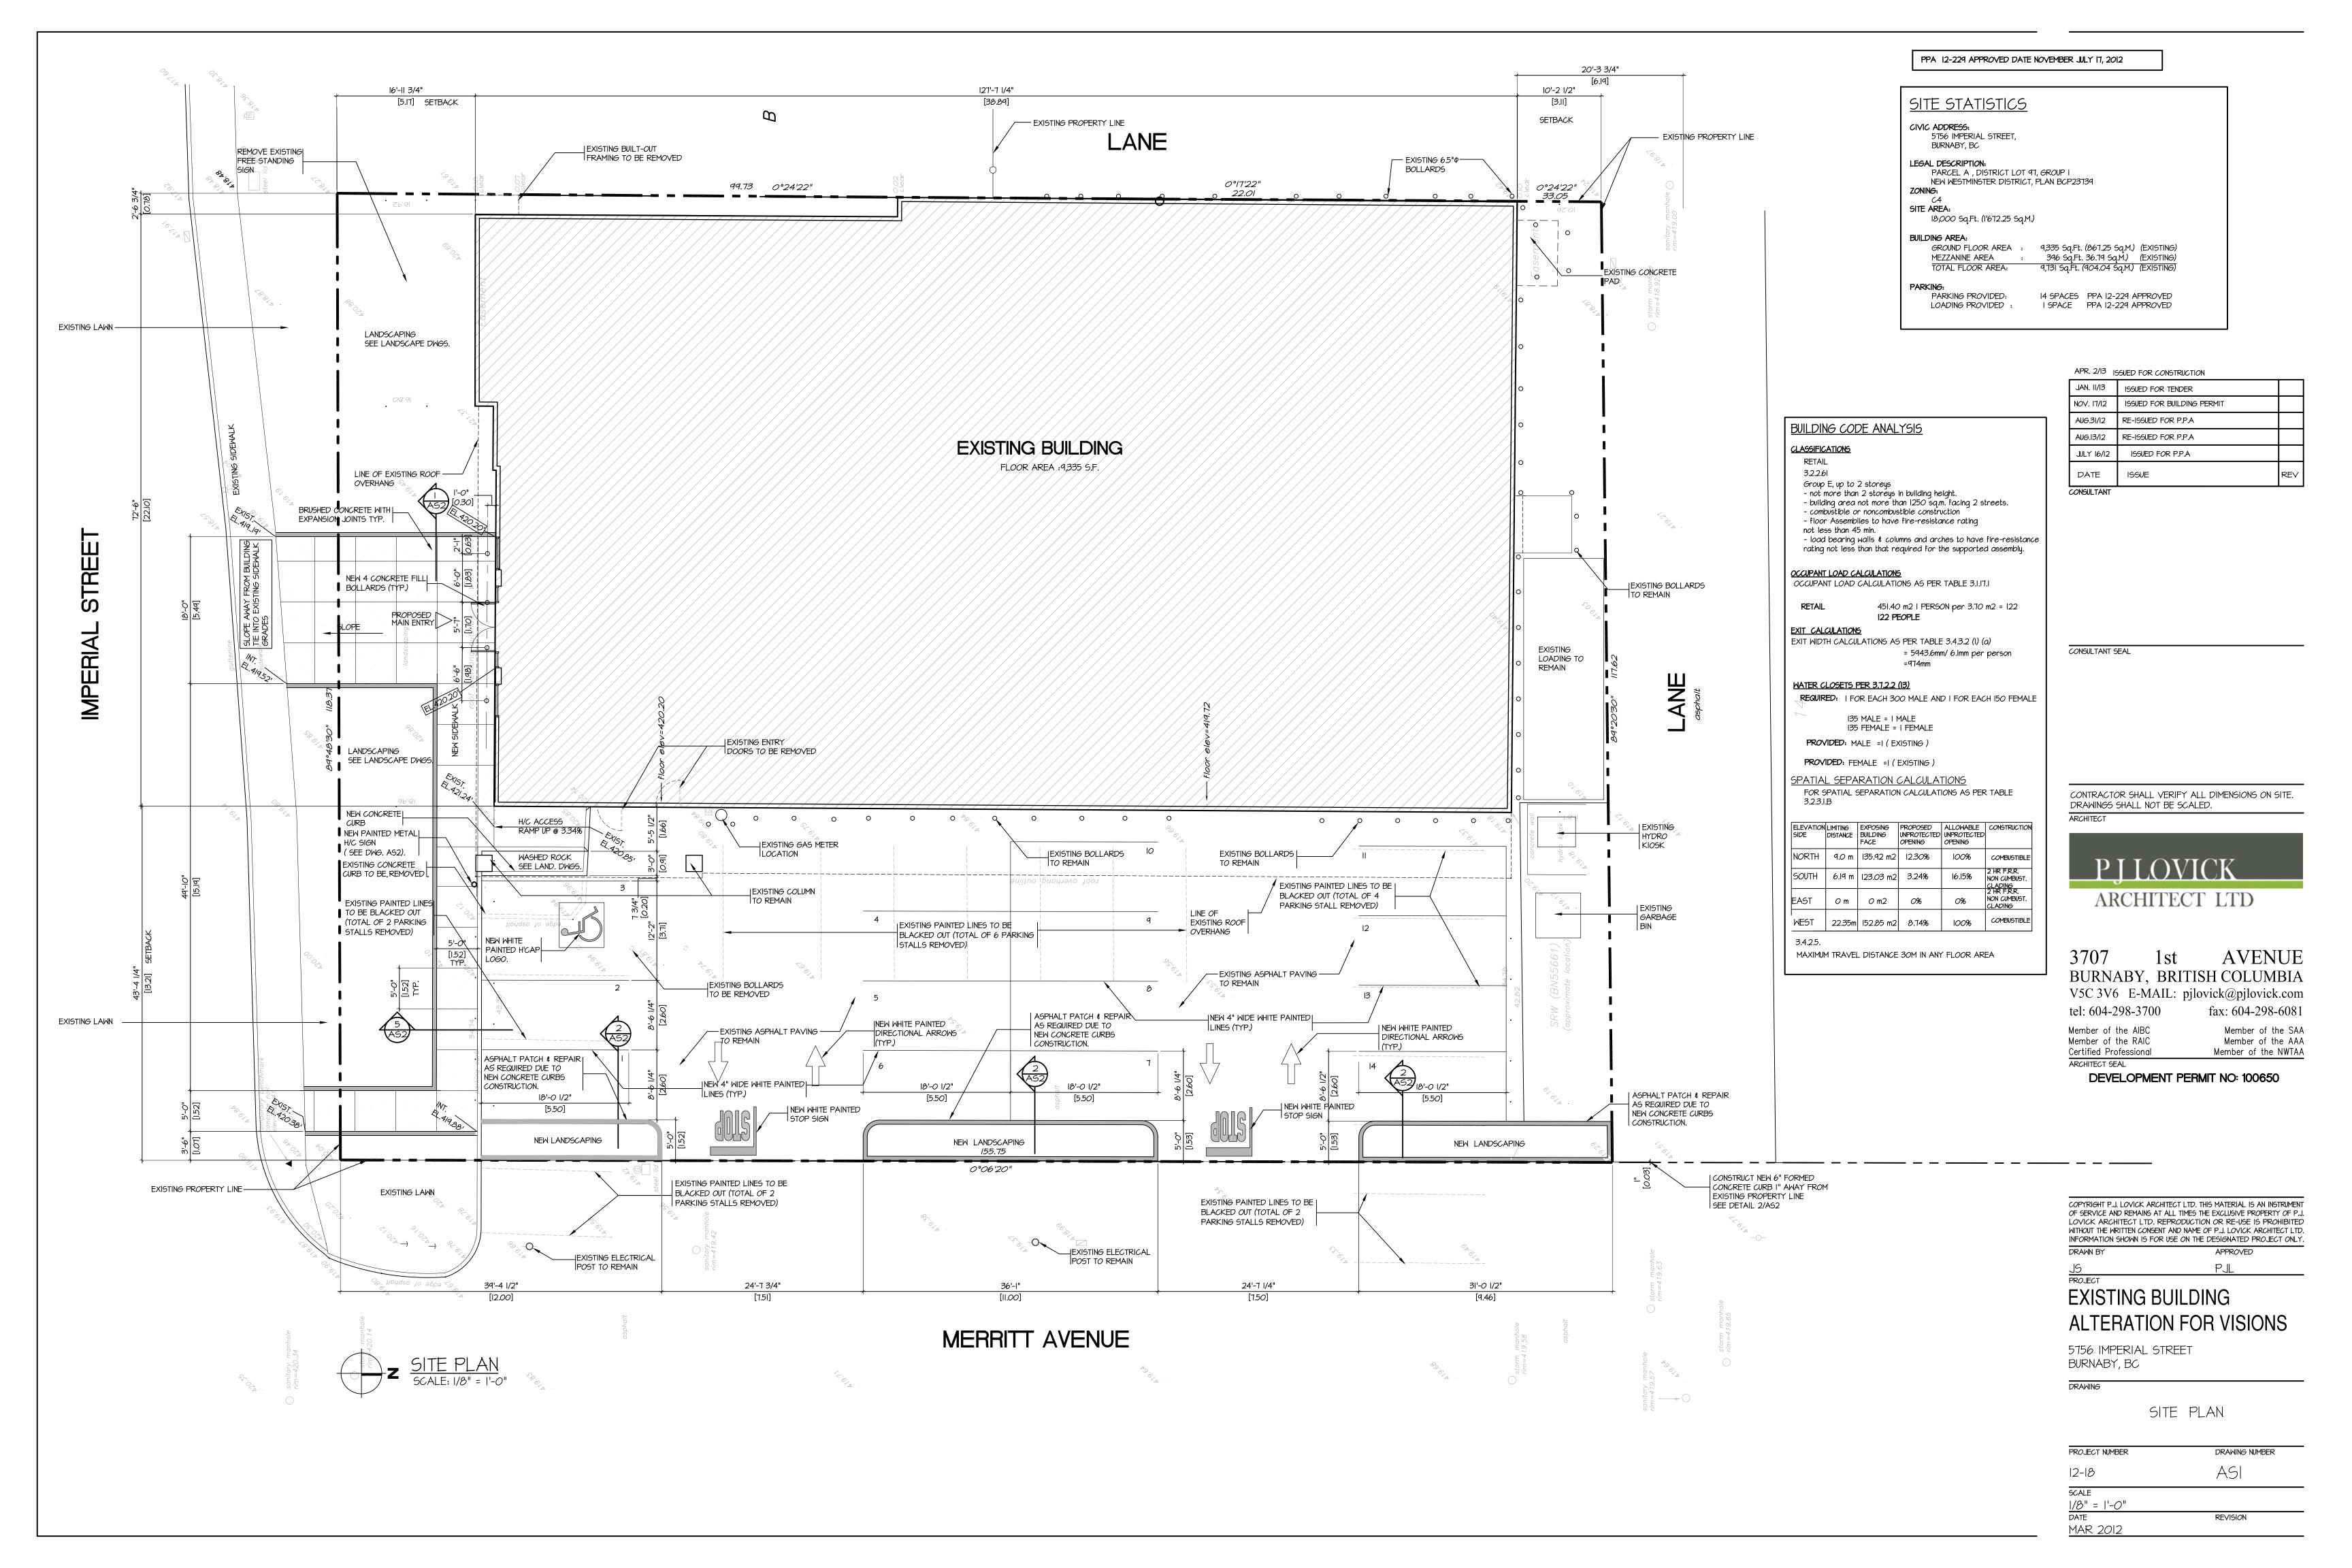


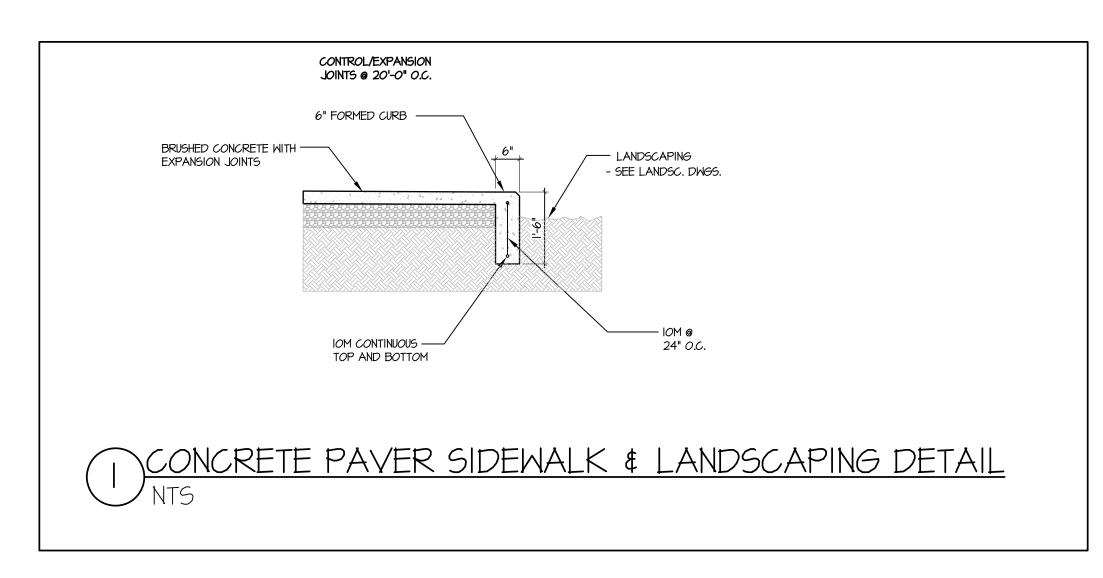


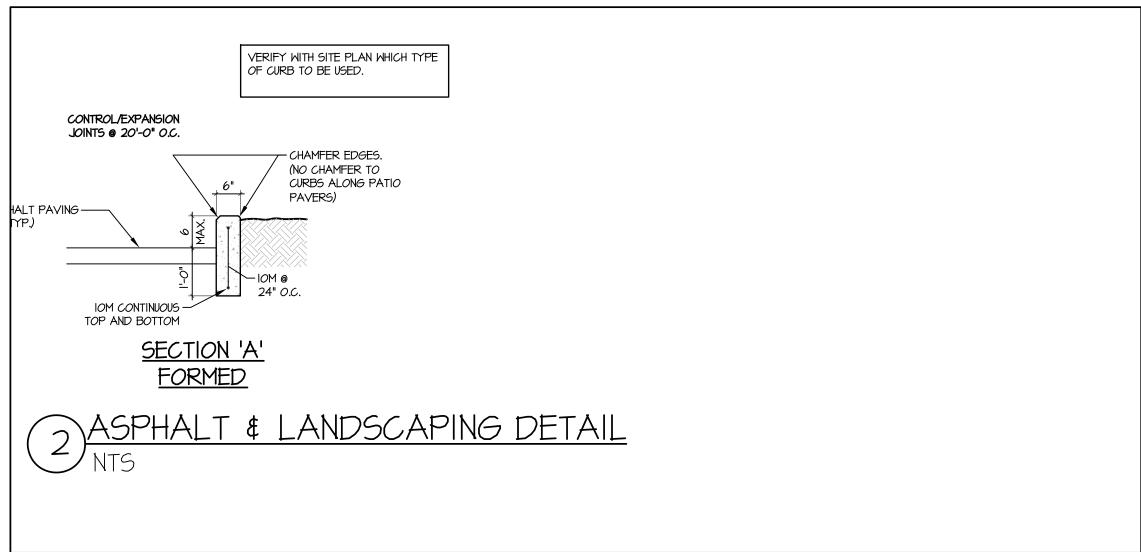

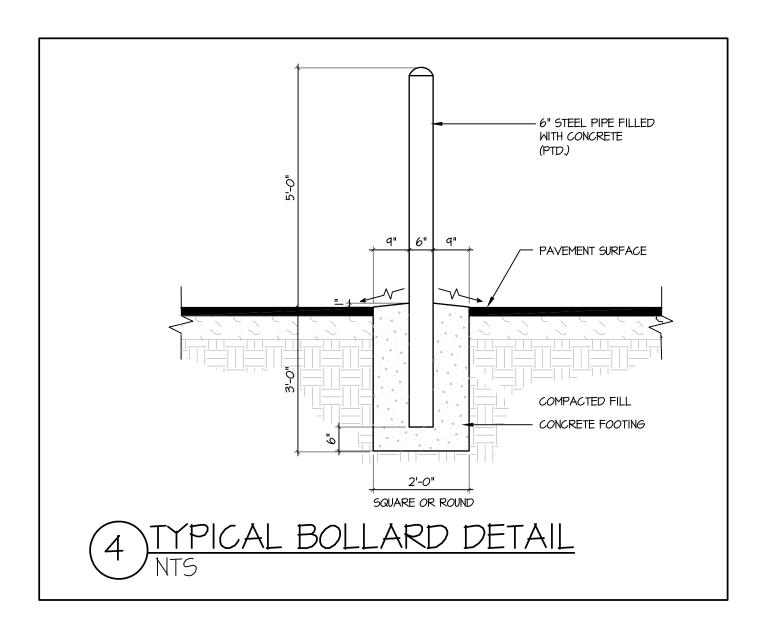

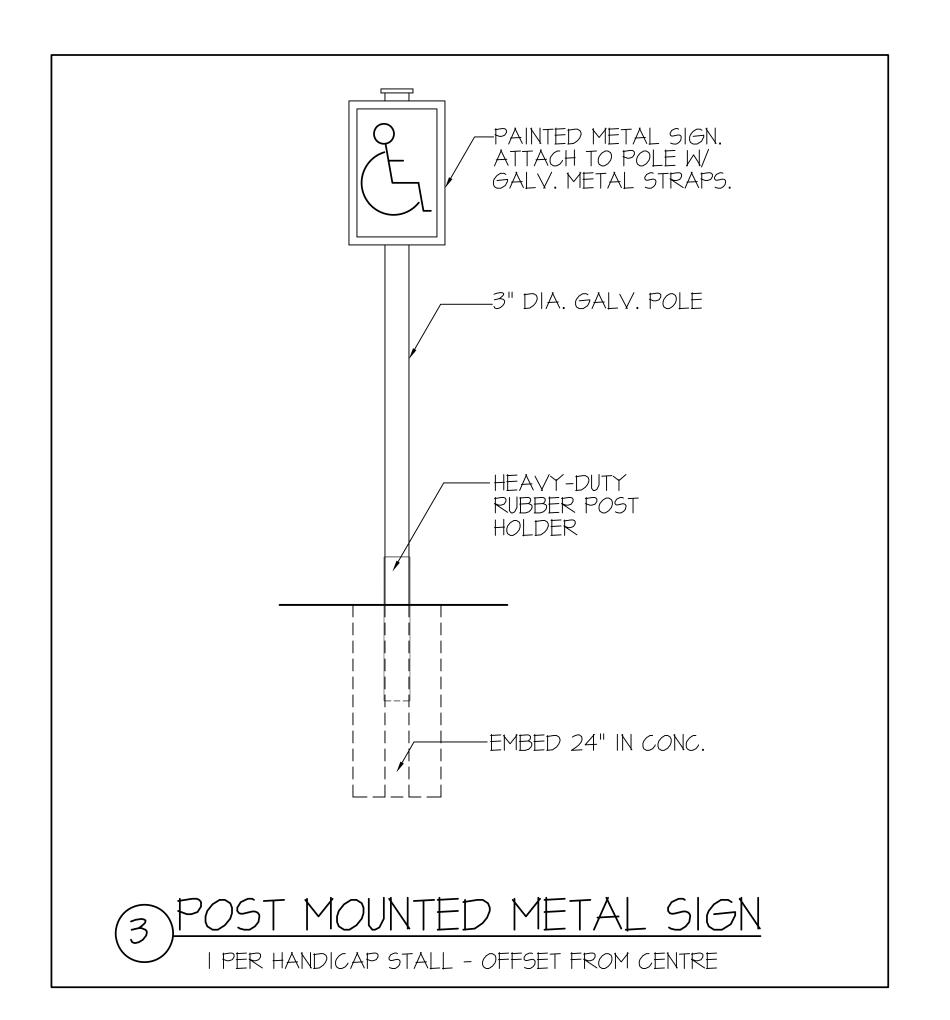

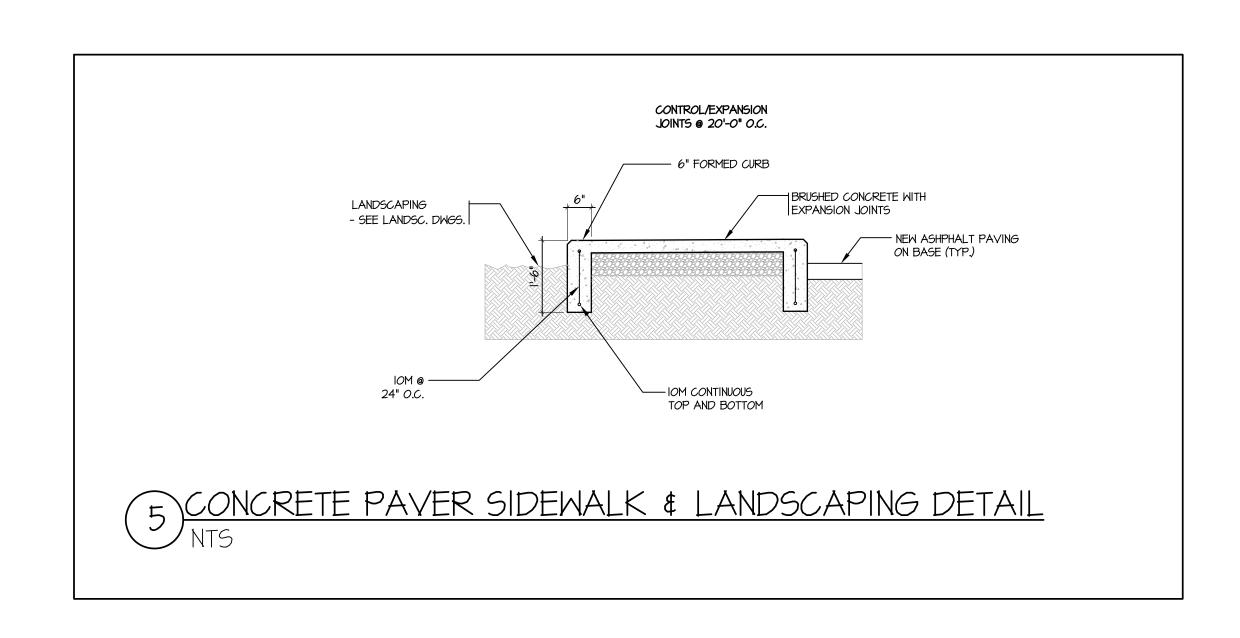

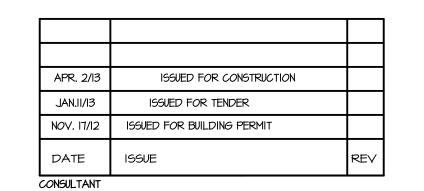

CONTRACTOR SHALL VERIFY ALL DIMENSIONS ON SITE. DRAWINGS SHALL NOT BE SCALED.



3707 1st AVENUE BURNABY, BRITISH COLUMBIA V5C 3V6 E-MAIL: pjlovick@pjlovick.com tel: 604-298-3700 fax: 604-298-6081

Member of the AIBC Member of the SAA
Member of the RAIC Member of the AAA
Certified Professional Member of the NWTAA
ARCHITECT SEAL

COPYRIGHT P.J. LOVICK ARCHITECT LTD. THIS MATERIAL IS AN INSTRUMENT OF SERVICE AND REMAINS AT ALL TIMES THE EXCLUSIVE PROPERTY OF P.J. LOVICK ARCHITECT LTD. REPRODUCTION OR RE-USE IS PROHIBITED WITHOUT THE WRITTEN CONSENT AND NAME OF P.J. LOVICK ARCHITECT LTD. INFORMATION SHOWN IS FOR USE ON THE DESIGNATED PROJECT ONLY.

PRO IECT


# EXISTING BUILDING ALTERATION FOR VISIONS

5756 IMPERIAL STREET BURNABY, BC


DRAWING

SITE DETAILS

DRAWING NUMBER
AS2
REVISION

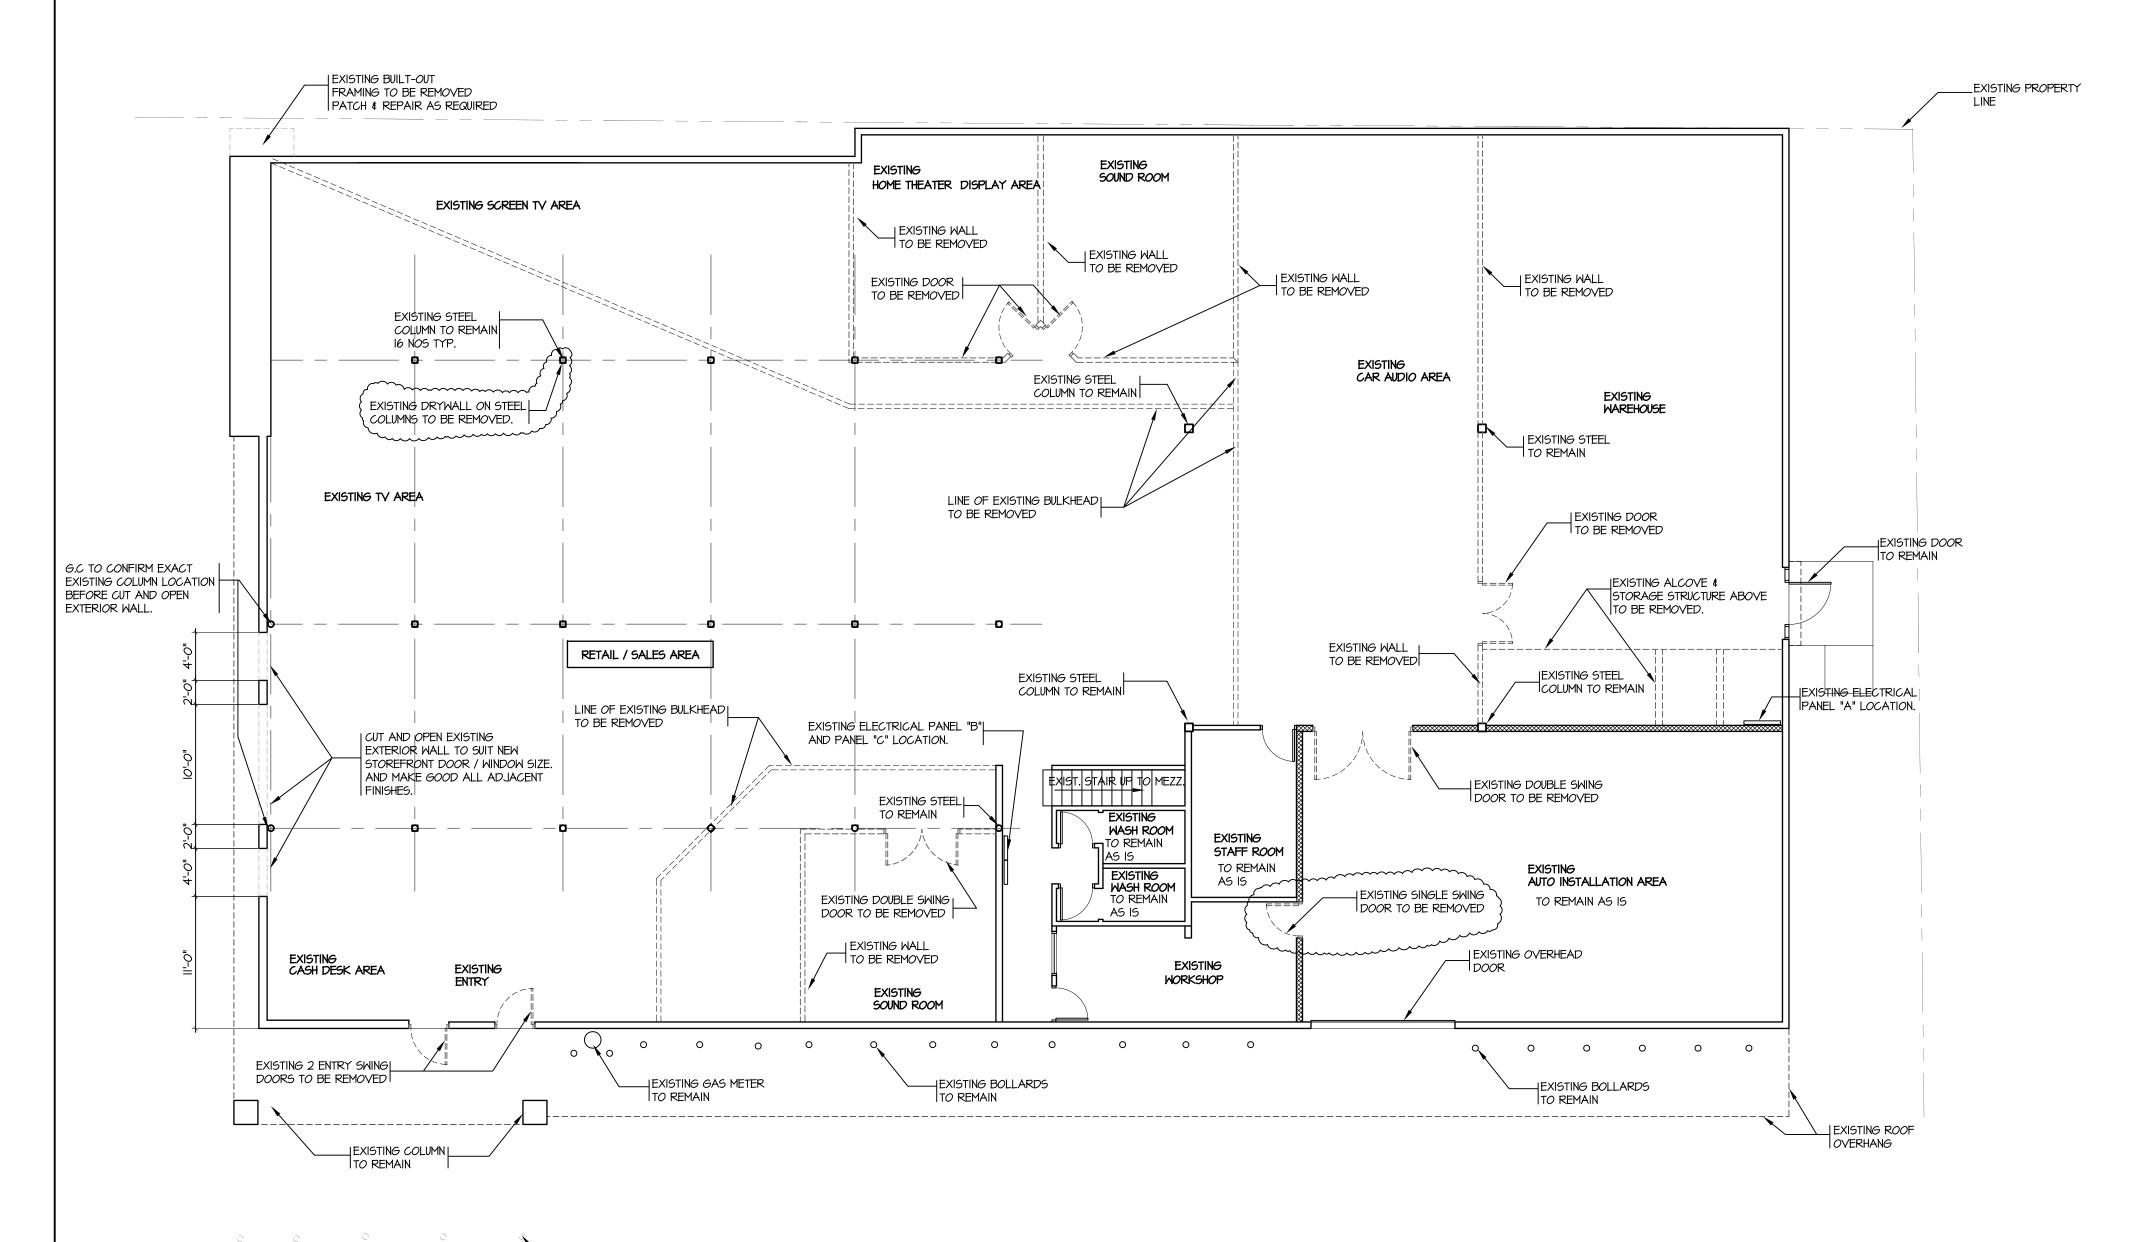



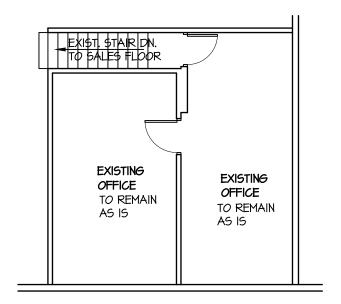





#### **DEMOLITION NOTES**

IT IS THE INTENT OF THESE DRAWINGS THAT THE AREA SHOWN IN THE SCOPE OF WORK BE PREPARED FOR NEW RENOVATION BY SELECTIVE DEMOLITION AND REMOVAL OF ITEMS INDICATED. SOME ITEMS WILL REQUIRE CAREFUL REMOVAL, STORAGE AND INVENTORY FOR REUSE IN THE RENOVATION.

- CONTRACTOR SHALL VERIFY FIELD CONDITIONS AND NOTIFY INTERIOR ARCHITECT OF ALL DISCREPANCIES BEFORE PROCEEDING WITH WORK.
- . PROVIDE AND MAINTAIN HOARDING, FIRE ALARM AND EXITING LIGHTING AND GUARD RAILS TO PROTECT OCCUPANTS OF BUILDING, WORKERS AND GUESTS, AND AS REQUIRED BY APPLICABLE REGULATORY ADVISORY.
- 3. ARRANGE AND PAY FOR DISCONNECTING, REMOVING AND CAPPING UTILITY SERVICES WITHIN AREAS OF DEMOLITION. DISCONNECT AND STUB OFF. NOTIFY THE AFFECTED UTILITY COMPANY AND ON SITE OPERATIONS MANAGER IN ADVANCE AND OBTAIN APPROVAL BEFORE STARTING THIS WORK.
- . ALL DEMOLISHED MATERIALS NOT FOR REUSE TO BE IMMEDIATELY REMOVED FROM SITE & PROPERLY DISPOSED OF.
- 5. PERFORM DEMOLITION IN ACCORDANCE WITH APPLICABLE AUTHORITIES HAVING
- 6. DEMOLISH EXISTING WALLS WITH CARE, DO NOT DAMAGE ADJACENT SURFACES NOTED TO REMAIN. PROVIDE TEMPORARY SHORING WHERE REQUIRED PRIOR TO REMOVAL OF STRUCTURAL FRAMING MEMBERS.
- . REPAIR ALL DEMOLITION PERFORMED IN EXCESS OF THAT REQUIRED AT NO COST TO THE OWNER.
- REMOVE DEMOLISHED MATERIALS, TOOLS AND EQUIPMENT FROM SITE UPON COMPLETION OF WORK, LEAVE SITE IN A CONDITION ACCEPTABLE TO THE OWNER AND ARCHITECT.
- 9. UPON DISCOVERY OF HAZARDOUS OR CONTAMINATED MATERIALS CONFORM TO APPLICABLE STATUTORY REQUIREMENTS AND IMMEDIATELY ADVISE ARCHITECT.
- IO. UPON DISCOVERY OF ANY ROT OR MOULD DURING CONSTRUCTION, CONTRACTOR IS TO INFORM THE ARCHITECT FOR REMEDIATION INSTRUCTIONS.
- II. CONFORM TO ALL APPLICABLE CODES FOR DEMOLITION WORK, SAFETY OF STRUCTURE, SAFETY OF MATERIALS HANDLING AND DUST CONTROL.
- 12. PRIOR TO CUTTING DOOR OPENINGS INTO EXISTING WALLS, OPEN CEILING TO CONFIRM THAT EXISTING WALL IS NOT LOAD-BEARING. IF WALL IS LOAD-BEARING CONTRACTOR MUST CONTACT STRUCTURAL ENGINEER FOR INSTRUCTIONS.
- 13. RELOCATE THERMOSTATS, RECEPTACLES, SWITCHES, FAN CONTROLS AND OTHER ELECTRICAL / MECHANICAL DEVICES ON DEMOLISHED WALLS.
- ANY EXISTING UNDER SLAB CONDUITS ARE FOUND WITH IN DEMOLISHED WALLS THEY ARE TO BE CAPPED LEVEL WITH SLAB AND EXISTING WIRING IS TO BE RUN OVER HEAD TO NEW LOCATION. IF WIRING IS NOT REQUIRED CONTRACTOR IS TO REMOVE.

APR. 2/13	ISSUED FOR CONSTRUCTION	
SI/II .NAL	ISSUED FOR TENDER	
DEC. 17/12	ISSUED FOR BUILDING PERMIT	
JULY 16/12	ISSUED FOR P.P.A	
DATE	ISSUE	REV

CONSULTANT SEAL

CONTRACTOR SHALL VERIFY ALL DIMENSIONS ON SITE. DRAWINGS SHALL NOT BE SCALED.



3707 1st AVENUE BURNABY, BRITISH COLUMBIA V5C 3V6 E-MAIL: pjlovick@pjlovick.com tel: 604-298-3700 fax: 604-298-6081

Member of the SAA

Member of the AAA

Member of the NWTAA

Member of the AIBC
Member of the RAIC
Certified Professional
ARCHITECT SEAL

COPYRIGHT P.J. LOVICK ARCHITECT LTD. THIS MATERIAL IS AN INSTRUMENT OF SERVICE AND REMAINS AT ALL TIMES THE EXCLUSIVE PROPERTY OF P.J. LOVICK ARCHITECT LTD. REPRODUCTION OR RE-USE IS PROHIBITED WITHOUT THE WRITTEN CONSENT AND NAME OF P.J. LOVICK ARCHITECT LTD. INFORMATION SHOWN IS FOR USE ON THE DESIGNATED PROJECT ONLY.

PROJECT

EXISTING BUILDING


### ALTERATION FOR VISIONS


5756 IMPERIAL STREET BURNABY, BC

DRAWING

DEMOLITION PLAN

PROJECT NUMBER	DRAWING NUMBER
12-18	Al
SCALE  /8" =  '-0"	
DATE	REVISION
MAR 2012	

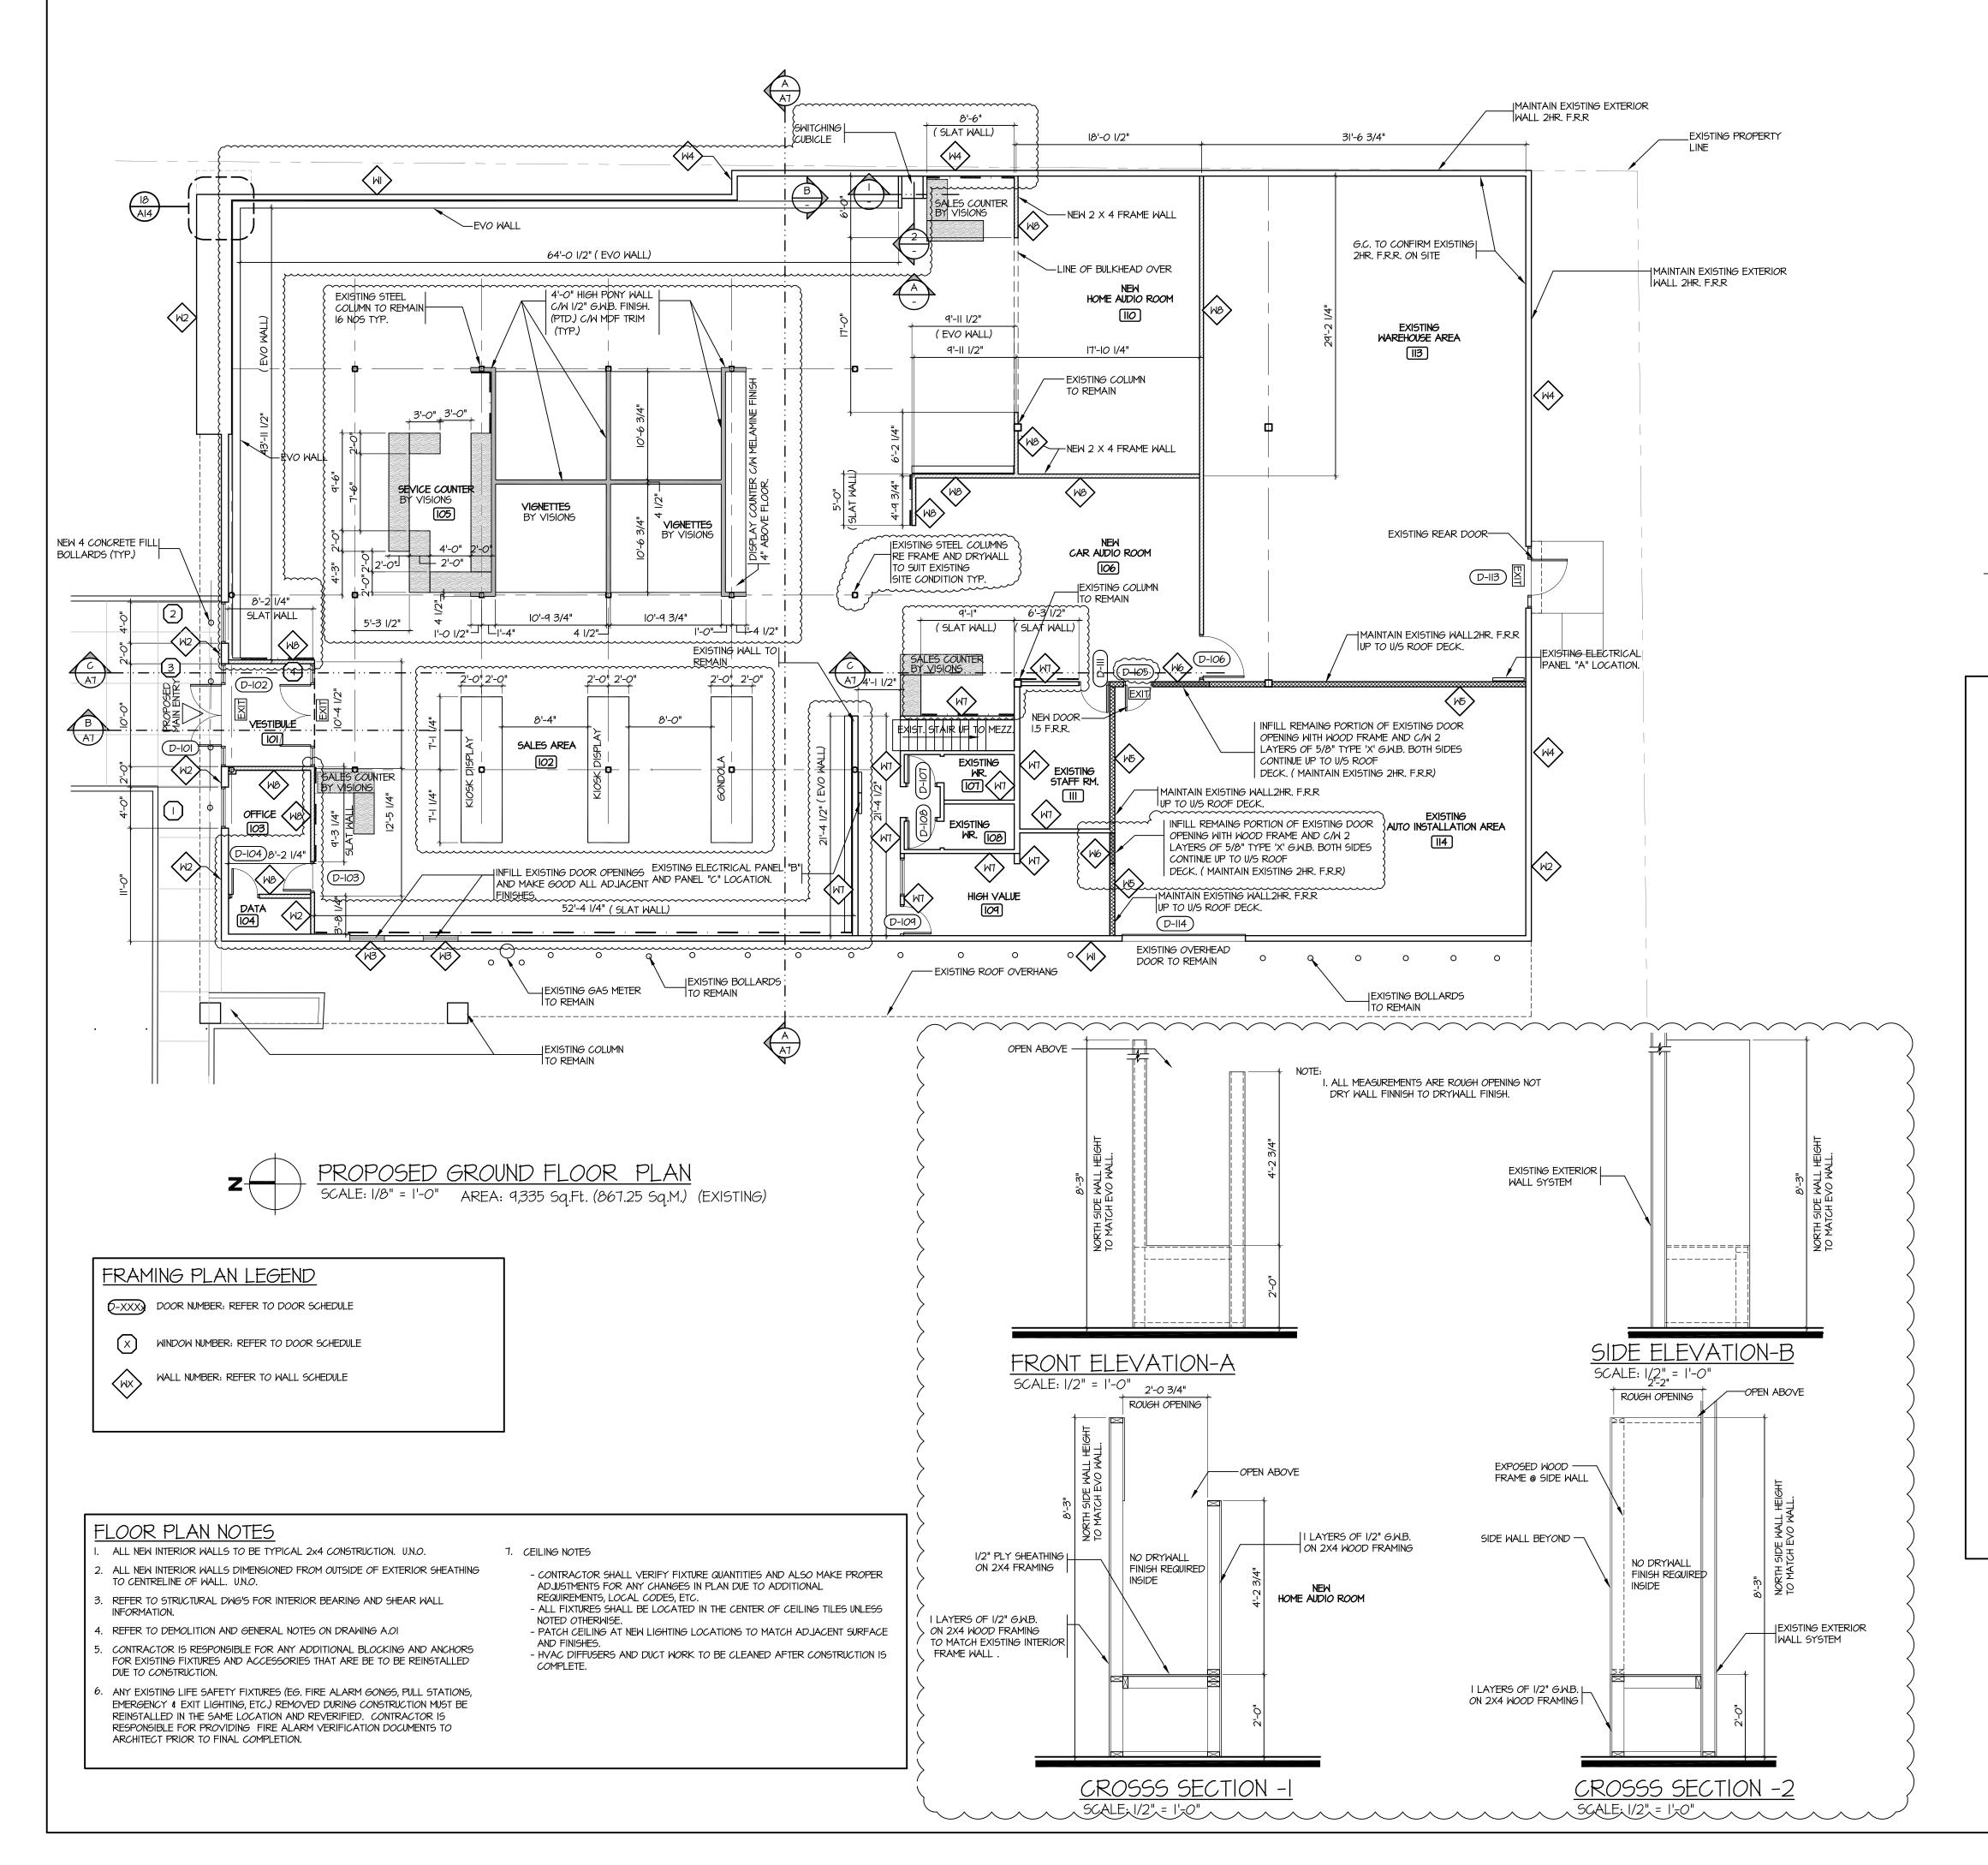

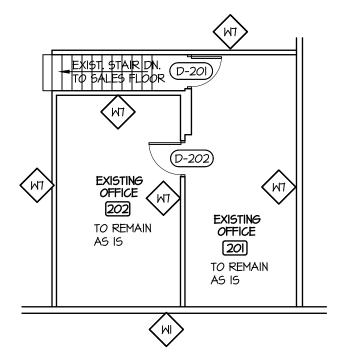

TYPICAL WALL ASSEMBLIES

AND REPLACE WITH

WIRE MESH

WIRE MESH

NEW STUCCO FINISH ON

STRAPPING @ 8" O.C.

( PATCH & REPAIR AS REQUIRED)

REMOVE EXISTING STUCCO FINISH

I/2" x 2" PT. VERTICAL PLYWOOD

EXISTING EXTERIOR SHEATHING

I/2" x 2" PT. VERTICAL PLYWOOD

1/2" EXTERIOR PLY SHEATHING ON

REMOVE EXISTING STUCCO FINISH

I/2" x 2" PT. VERTICAL PLYWOOD

2 LAYERS 30 MIN. BUILDING PAPER ON

ON EXISTING EXTERIOR WALL SYSTEM

(LAYER LINE AND JOINTS TO BE LAPPED)

EXISTING INTERIOR 2HR. F.R.R. FRAME WALL TO REMAIN

BOTH SIDES ON 2X4 OR 2X6 TO MATCH EXISTING

(5/8" TYPE 'X' CONTINUE UP TO U/S ROOF DECK.)

EXISTING INTERIOR FRAME WALLS TO REMAIN

I LAYERS OF I/2" OR 5/8" TYPE 'X' G.W.B.

BOTH SIDES ON 2X4 OR 2X6 TO MATCH EXISTING

2 LAYERS OF 5/8" TYPE 'X' G.W.B.

STRAPPING @ 8" O.C. MAX.

R20 BATT INSULATION C/W

6MIL POLY VAPOR BARRIER

2 LAYERS 30 MIN. BUILDING PAPER ON

(LAYER LINE AND JOINTS TO BE LAPPED)

EXISTING WALL FRAMING

NEW STUCCO FINISH ON

STRAPPING @ 8" O.C.

1/2" G.W.B. (PTD.)

AND REPLACE WITH

NEW INTERIOR 2HR. F.R.R. FRAME WALL

INTERIOR FRAME WALL.

NEW INTERIOR FRAME WALLS

INTERIOR FRAME WALL .

EXISTING TO BE REMOVED:

-DOORS & WINDOWS

2 LAYERS 30 MIN. BUILDING PAPER ON

(LAYER LINE AND JOINTS TO BE LAPPED)

NEW STUCCO FINISH ON NEW EXTERIOR FRAME WALL

2X4 OR 2X6 WOOD STUDS ( TO MATCH EXISTING)

MAINTAIN EXISTING 2 HR. FIRE RESISTANT RATING

NEW VICWEST CLADDING 22 GA.(PROFILE -CL

435PAINTED (INSTALLED PER MANUFACTURE'S SPEC'S)

NEW VICWEST CLADDING ON EXISTING EXTERIOR FRAME WALL

EXISTING STUCCO FINISH ON EXTERIOR FRAME WALL

NEW STUCCO FINISH ON EXISTING EXTERIOR FRAME WALL

APR. 2/13	ISSUED FOR CONSTRUCTION	
MAR. 26/13	ADDENDUM #3	
JAN. II/I3	ISSUED FOR TENDER	
DEC. 17/12	ISSUED FOR BUILDING PERMIT	
JULY 16/12	ISSUED FOR P.P.A	
DATE	ISSUE	REV
ONSULTANT	<u> </u>	

CONTRACTOR SHALL VERIFY ALL DIMENSIONS ON SITE. DRAWINGS SHALL NOT BE SCALED.



**AVENUE** 1st BURNABY, BRITISH COLUMBIA V5C 3V6 E-MAIL: pjlovick@pjlovick.com tel: 604-298-3700 fax: 604-298-6081

Member of the AIBC Member of the RAIC

CONSULTANT SEAL

Member of the SAA Member of the AAA Certified Professional Member of the NWTAA ARCHITECT SEAL

COPYRIGHT P.J. LOVICK ARCHITECT LTD. THIS MATERIAL IS AN INSTRUMENT OF SERVICE AND REMAINS AT ALL TIMES THE EXCLUSIVE PROPERTY OF P.J. LOVICK ARCHITECT LTD. REPRODUCTION OR RE-USE IS PROHIBITED WITHOUT THE WRITTEN CONSENT AND NAME OF P.J. LOVICK ARCHITECT LTD. INFORMATION SHOWN IS FOR USE ON THE DESIGNATED PROJECT ONLY.


### **EXISTING BUILDING** ALTERATION FOR VISIONS

5756 IMPERIAL STREET BURNABY, BC

PROPOSED MAIN FLOOR & EXISTING MEZZANINE PLAN


PROJECT NUMBER	DRAWING NUMBER
12-18	A2
SCALE  /8" =  '-0"	
DATE	REVISION .
MAR 2012	



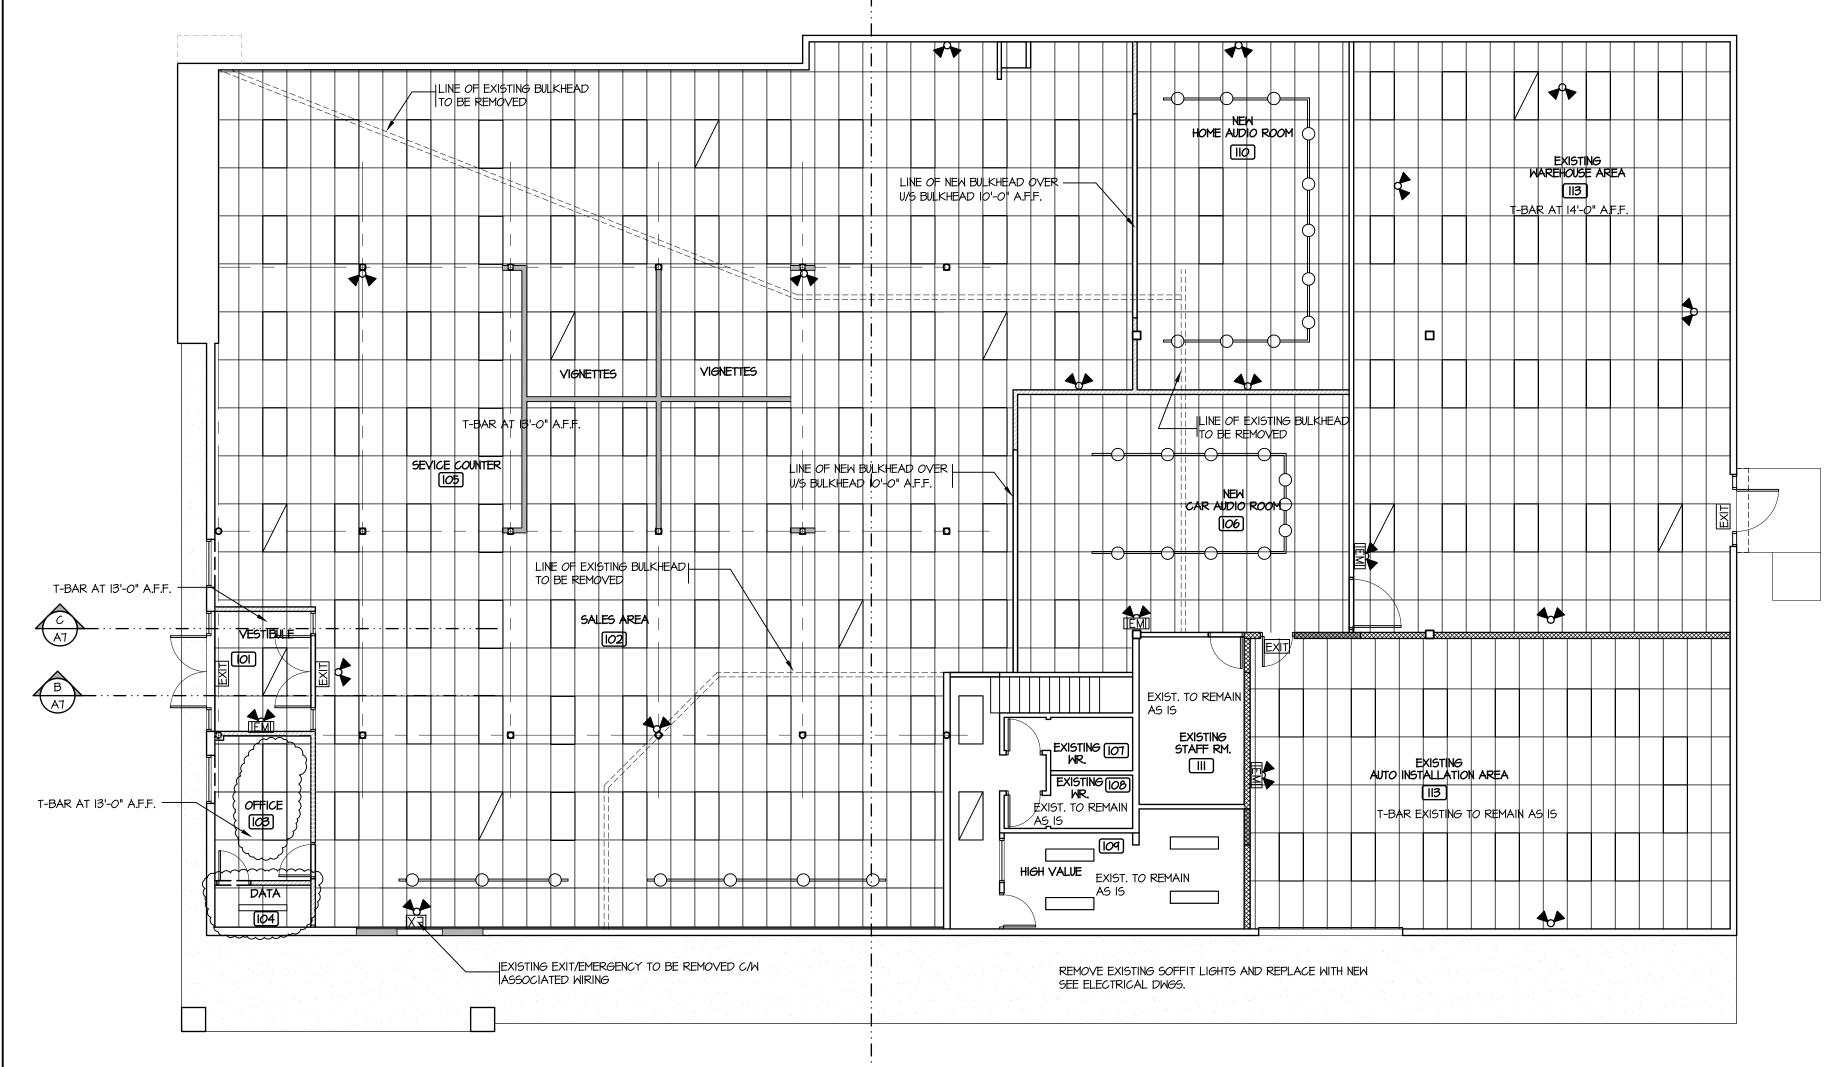





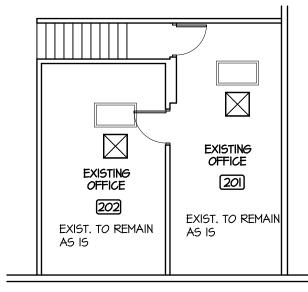



#### REFLECTED CEILING PLAN NOTES

- I. GENERAL CONTRACTOR TO VERIFY THE LOCATION OF EXISTING TRUSSES AND DETERMINE IF THERE IS A CONFLICT WITH THE PROPOSED T-BAR CEILING LAYOUT. NOTIFY ARCHITECT OF CONFLICT & COORDINATE REQUIRED ADJUSTMENTS.
- 2. PROVIDE ADEQUATE CLEARANCES FOR FIXTURES, DUCTS AND CEILING ITEMS NECESSARY TO MAINTAIN THE SPECIFIED HEIGHT ABOVE FINISHED FLOOR.
- 3. SEE ELECTRICAL DRAWINGS FOR FIXTURE MODEL NUMBER & QUANTITIES AND FOR LOCATION OF REQUIRED NEW AND/OR RELOCATED LIFE SAFETY DEVICES.
- ADDITIONAL HANGAR AND SAFETY WIRES FOR LIGHT FIXTURES AND AIR SUPPLY/RETURN DIFFUSERS (AS REQUIRED BY LOCAL CODES) TO BE THE RESPONSIBILITY OF THE SUB-CONTRACTOR.
- 5. SEE MECHANICAL DRAWINGS FOR ADJUSTED OR NEW DIFFUSER LOCATIONS.
- 6. CONTRACTOR IS RESPONSIBLE FOR SEISMIC BRACING & ENGINEERING FOR T-BAR, BULKHEADS, LUMINARIES & MECHANICAL EQUIPMENT TO MEET LOCAL AUTHORITIES REQUIREMENTS.

	APR. 2/13	ISSUED FOR CONSTRUCTION	
	JAN. II/I3	ISSUED FOR TENDER	
	DEC. 17/12	ISSUED FOR BUILDING PERMIT	
	JULY 16/12	ISSUED FOR P.P.A	
	DATE	ISSUE	REV
7	CONSULTANT		

CONSULTANT SEAL

CONTRACTOR SHALL VERIFY ALL DIMENSIONS ON SITE. DRAWINGS SHALL NOT BE SCALED.



3707 1st AVENUE BURNABY, BRITISH COLUMBIA V5C 3V6 E-MAIL: pjlovick@pjlovick.com tel: 604-298-3700 fax: 604-298-6081

Member of the AIBC Member of the RAIC Certified Professional ARCHITECT SEAL

of the AIBC Member of the SAA of the RAIC Member of the AAA Professional Member of the NWTAA

COPYRIGHT P.J. LOVICK ARCHITECT LTD. THIS MATERIAL IS AN INSTRUMENT OF SERVICE AND REMAINS AT ALL TIMES THE EXCLUSIVE PROPERTY OF P.J. LOVICK ARCHITECT LTD. REPRODUCTION OR RE-USE IS PROHIBITED WITHOUT THE WRITTEN CONSENT AND NAME OF P.J. LOVICK ARCHITECT LTD. INFORMATION SHOWN IS FOR USE ON THE DESIGNATED PROJECT ONLY.

EXISTING BUILDING
ALTERATION FOR VISIONS

5756 IMPERIAL STREET BURNABY, BC

DRAMING

PROPOSED MAIN FLOOR REFLECTED CEILING PLAN

PROJECT NUMBER

12-18


SCALE

1/8" = 1'-0"

DATE

REVISION

SEPTEMBER 2012

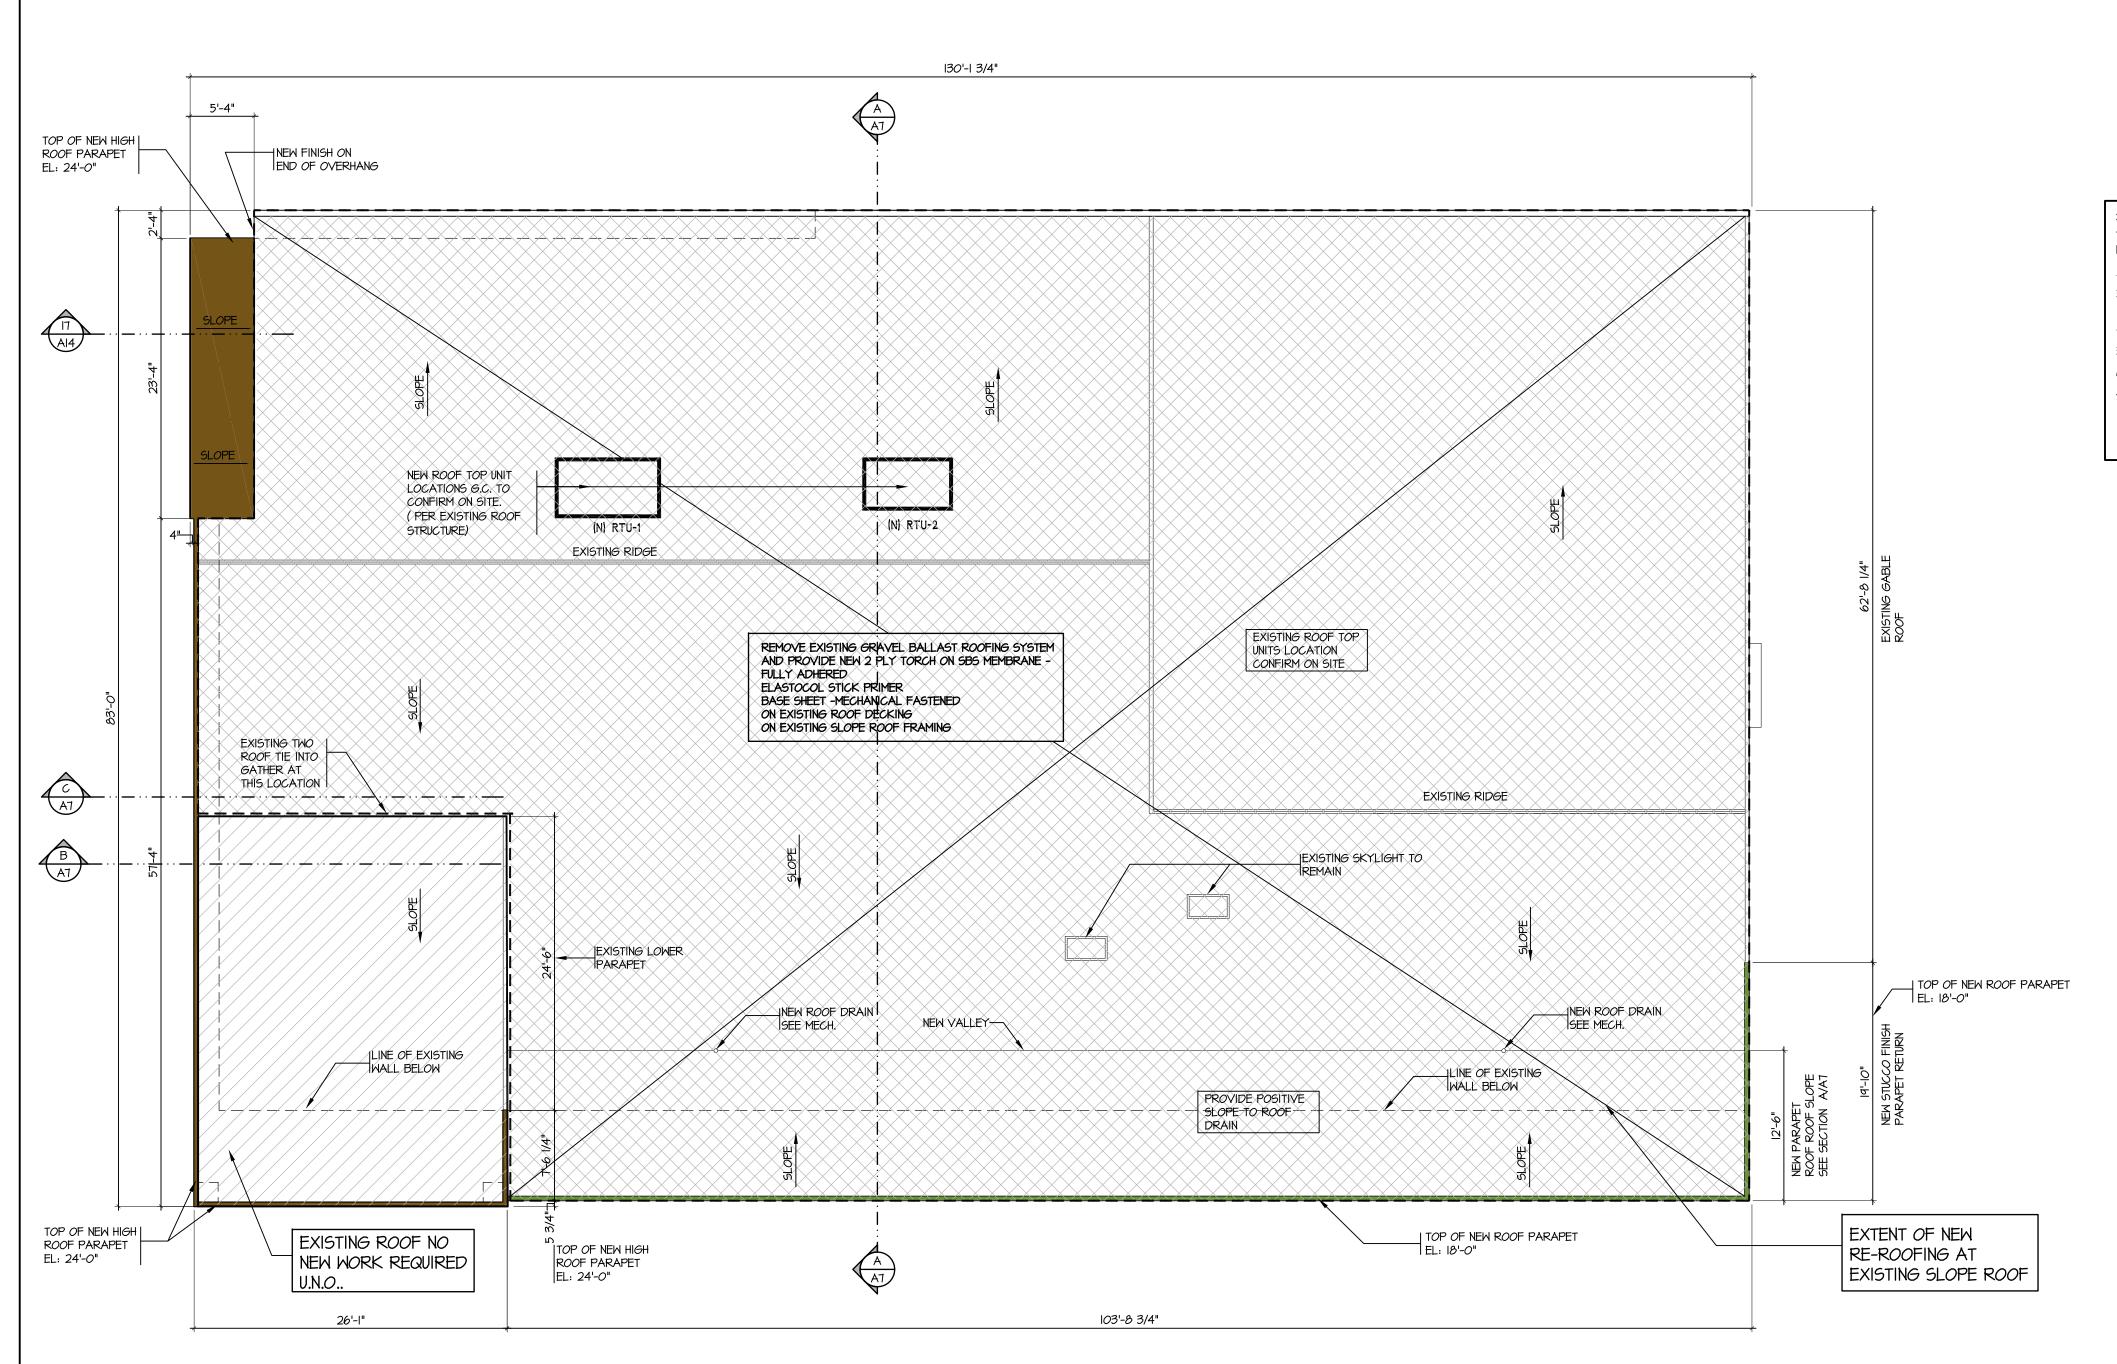



NEW HIGH PARAPET T.O. PARAPET HEIGHT @ 24'-O" (VERIFY ON SITE)

NEW MAIN PARAPET T.O. PARAPET HEIGHT @ 18'-O" (VERIFY ON SITE)

#### ROOF PLAN NOTES

- WASH ALL SURFACES AND REPAIR AS NECESSARY PRIOR TO APPLYING PAINT.
- 2. MAINTAIN ALL EXISTING ROOF SLOPES AND DRAINAGE.
- PROVIDE BUILT UP SADDLES AROUND ALL NEW ROOF TOP EQUIPMENT TO MAINTAIN DRAINAGE.
- 4. CAULK, SEAL AND MAKE GOOD ALL NEW ROOF PENETRATIONS.
- 5. LOCATE ALL NEW ROOF TOP EQUIPMENT AS PER MECHANICAL DRAWINGS.
- 6. REFER TO STRUCTURAL DRAWINGS FOR NEW ROOF FRAMING.

MAINTAIN AND OR EXTEND ALL EXISTING SCUPPERS THRU NEW PARAPET FRAMING AS REQUIRED. ALL EXTENSION TO BE

APR. 2/13	ISSUED FOR CONSTRUCTION	
JAN. II/I3	ISSUED FOR TENDER	
DEC. 17/12	ISSUED FOR BUILDING PERMIT	
JULY 16/12	ISSUED FOR P.P.A	
DATE	ISSUE	REV
CONSULTANT		

CONSULTANT SEAL

CONTRACTOR SHALL VERIFY ALL DIMENSIONS ON SITE. DRAWINGS SHALL NOT BE SCALED.



**AVENUE** 3707 1st BURNABY, BRITISH COLUMBIA V5C 3V6 E-MAIL: pjlovick@pjlovick.com tel: 604-298-3700 fax: 604-298-6081

Member of the AIBC Member of the SAA Member of the RAIC Member of the AAA Certified Professional Member of the NWTAA ARCHITECT SEAL

COPYRIGHT P.J. LOVICK ARCHITECT LTD. THIS MATERIAL IS AN INSTRUMENT OF SERVICE AND REMAINS AT ALL TIMES THE EXCLUSIVE PROPERTY OF P.J. LOVICK ARCHITECT LTD. REPRODUCTION OR RE-USE IS PROHIBITED WITHOUT THE WRITTEN CONSENT AND NAME OF P.J. LOVICK ARCHITECT LTD. INFORMATION SHOWN IS FOR USE ON THE DESIGNATED PROJECT ONLY.


**EXISTING BUILDING** 


### ALTERATION FOR VISIONS


5756 IMPERIAL STREET BURNABY, BC

EXISTING ROOF PLAN

PROJECT NUMBER	DRAWING NUMBER
12-18	A4
SCALE	
1/8" = 1'-0"	
DATE	REVISION
SEPTEMBER 2012	

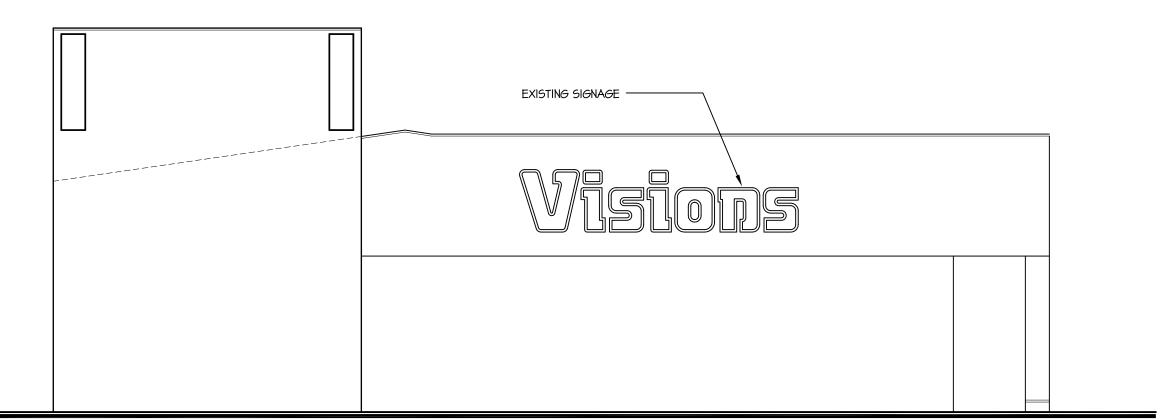


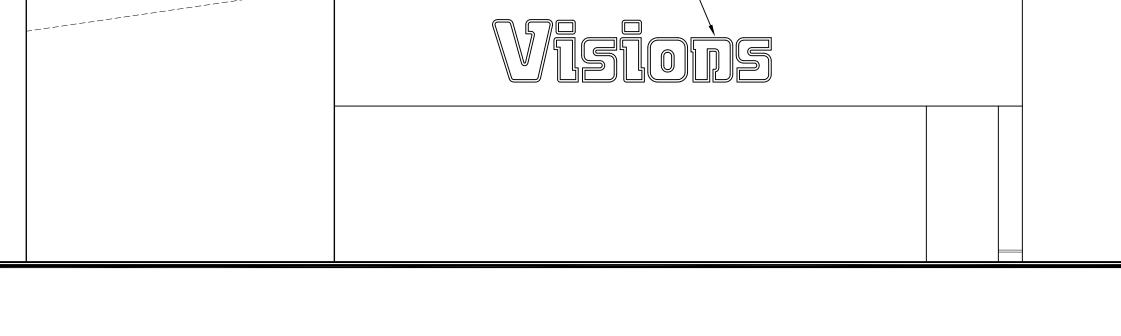

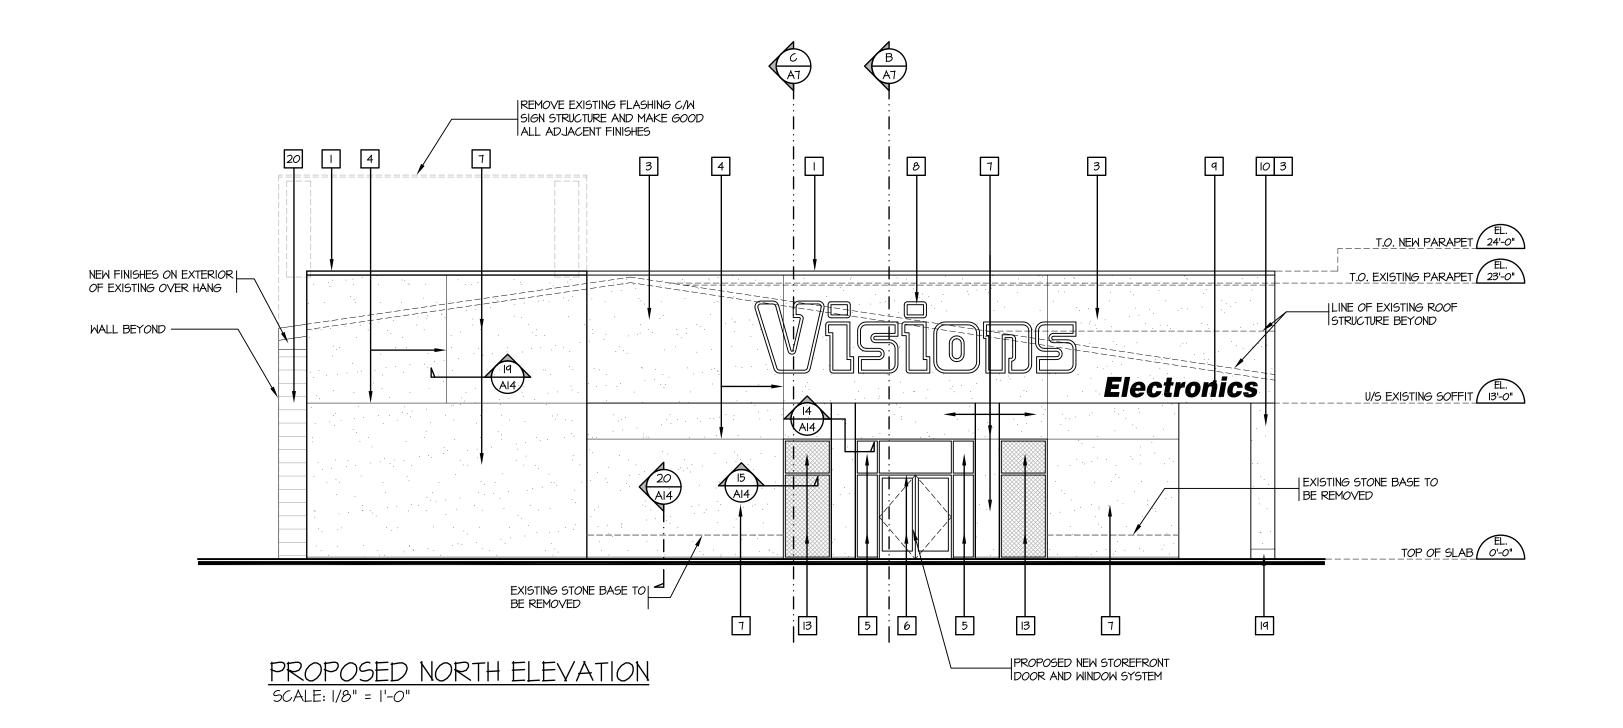

APR. 2/13	ISSUED FOR CONSTRUCTION	
Jan. II/I3	ISSUED FOR TENDER	
DEC. 17/12	ISSUED FOR BUILDING PERMIT	
JULY 16/12	ISSUED FOR P.P.A	-
DATE	ISSUE	REV
CONSULTANT		


#### EXISTING NORTH ELEVATION SCALE: 1/8" = 1'-0"

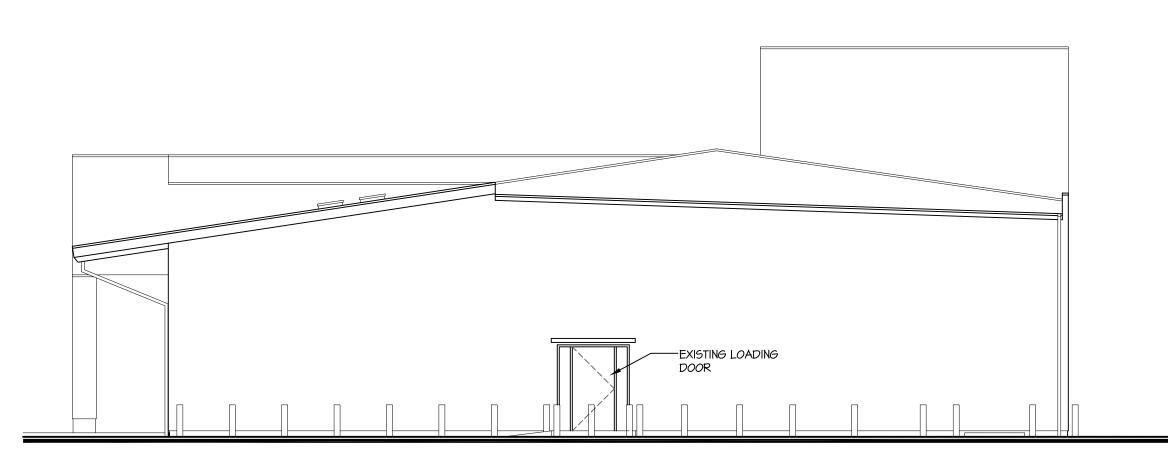

EXISTING SOUTH ELEVATION

SCALE: 1/8" = 1'-0"

	TERIOR FINISHES LOURS TO BE CONFIRMED PRIOR TO PAINTING	* ALL MATERIAL FLASHING TO BE 24 GA.
NO.	MATERIAL	COLOUR
1	* NEW PREFINISHED METAL CAP FLASHING	RED CORAL (TO MATCH BM: R-9909)
2	EXISTING METAL FLASHING	PAINTED TO MATCH RED CORAL (TO MATCH BM: R-9909)
3	NEW STUCCO FINISH	JET BLUE (BM: CC-870)
4	NEW STUCCO REVEAL/ EXPANSION JOINT	TO MATCH ADJACENT COLOUR
5	NEW STOREFRONT WINDOW & FRAME	CLEAR ANODIZED ALUMINUM
6	NEW STOREFRONT DOOR & FRAME	CLEAR ANODIZED ALUMINUM
7	NEW STUCCO FINISH	PAINTED TO MATCH LATE WHEAT (BM: CC-240)
8	EXISTING " VISION" SIGNAGE	TO REMAIN
9	NEW " ELECTRONIC"SIGNAGE	BY SIGN SUPPLIER
Ю	EXISTING COLUMNS	JET BLUE (BM: CC-870)
II	EXISTING OVERHAED DOOR	PAINTED TO MATCH RED CORAL (TO MATCH BM: R-9909)
12	EXISTING METAL DOOR	PAINTED TO MATCH RED CORAL (TO MATCH BM: R-9909)
13	SPANDREL GLAZING	SEE NOTE:
14	EXISTING SLOPE ROOF	TO REMAIN
15	EXISTING ROOF FASCIA	TO MATCH ADJACENT COLOUR
16	EXISTING SKYLIGHT	TO REMAIN
17	EXISTING BOLLARDS	SAFETY YELLOW
18	EXISTING R.W.L.	TO REMAIN
19	EXISTING CONCRETE BASE	TO REMAIN
20	METAL SIDING - VICWEST CL435	
21	NEW " VISION" SIGNAGE	BY OWNER
22	EXISTING STUCCO FINISH	PAINTED TO MATCH LATE WHEAT (BM: CC-240)

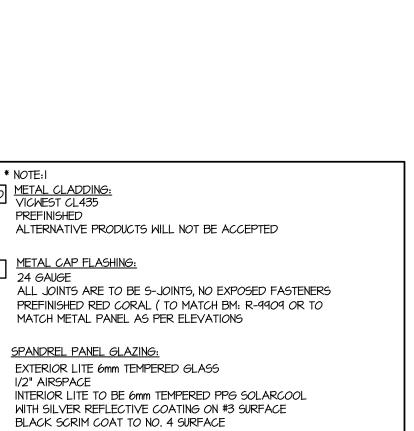


\* NOTE:I

20 METAL CLADDING: VICWEST CL435 PREFINISHED

METAL CAP FLASHING: 24 GAUGE

1/2" AIRSPACE

NOTE: Signs will vary to suit tenant's requirement's and to comply with Sign by-law. Separate permits are required.

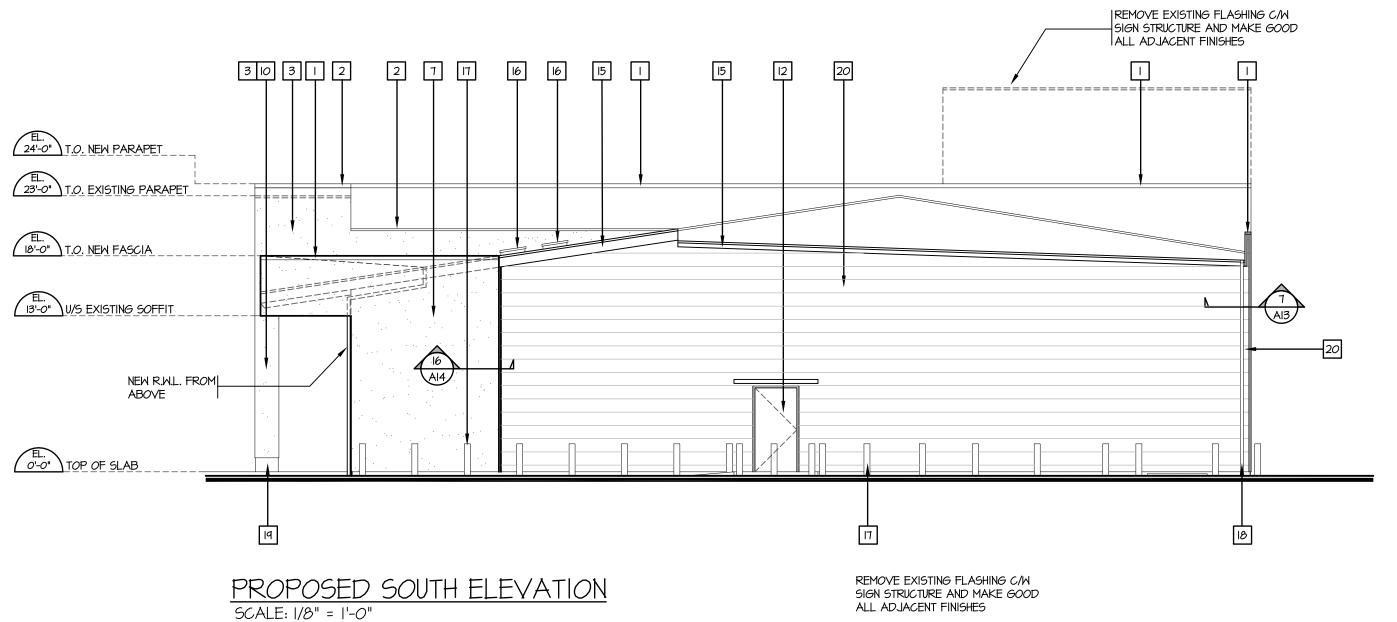

CONTRACTOR SHALL VERIFY ALL DIMENSIONS ON SITE. DRAWINGS SHALL NOT BE SCALED.



**AVENUE** 3707 1st BURNABY, BRITISH COLUMBIA V5C 3V6 E-MAIL: pjlovick@pjlovick.com fax: 604-298-6081 tel: 604-298-3700

Member of the AIBC Member of the RAIC Certified Professional ARCHITECT SEAL

CONSULTANT SEAL

Member of the SAA Member of the AAA Member of the NWTAA

COPYRIGHT P.J. LOVICK ARCHITECT LTD. THIS MATERIAL IS AN INSTRUMENT OF SERVICE AND REMAINS AT ALL TIMES THE EXCLUSIVE PROPERTY OF P.J. LOVICK ARCHITECT LTD. REPRODUCTION OR RE-USE IS PROHIBITED WITHOUT THE WRITTEN CONSENT AND NAME OF P.J. LOVICK ARCHITECT LTD. INFORMATION SHOWN IS FOR USE ON THE DESIGNATED PROJECT ONLY.


**EXISTING BUILDING** 

### ALTERATION FOR VISIONS

5756 IMPERIAL STREET BURNABY, BC

DRAWING EXISTING / PROPOSED NORTH & SOUTH BUILDING ELEVATION

PROJECT NUMBER	DRAWING NUMBER
12-18	A5
5CALE  /8" =  '-0"	
date MAR 2012	REVISION

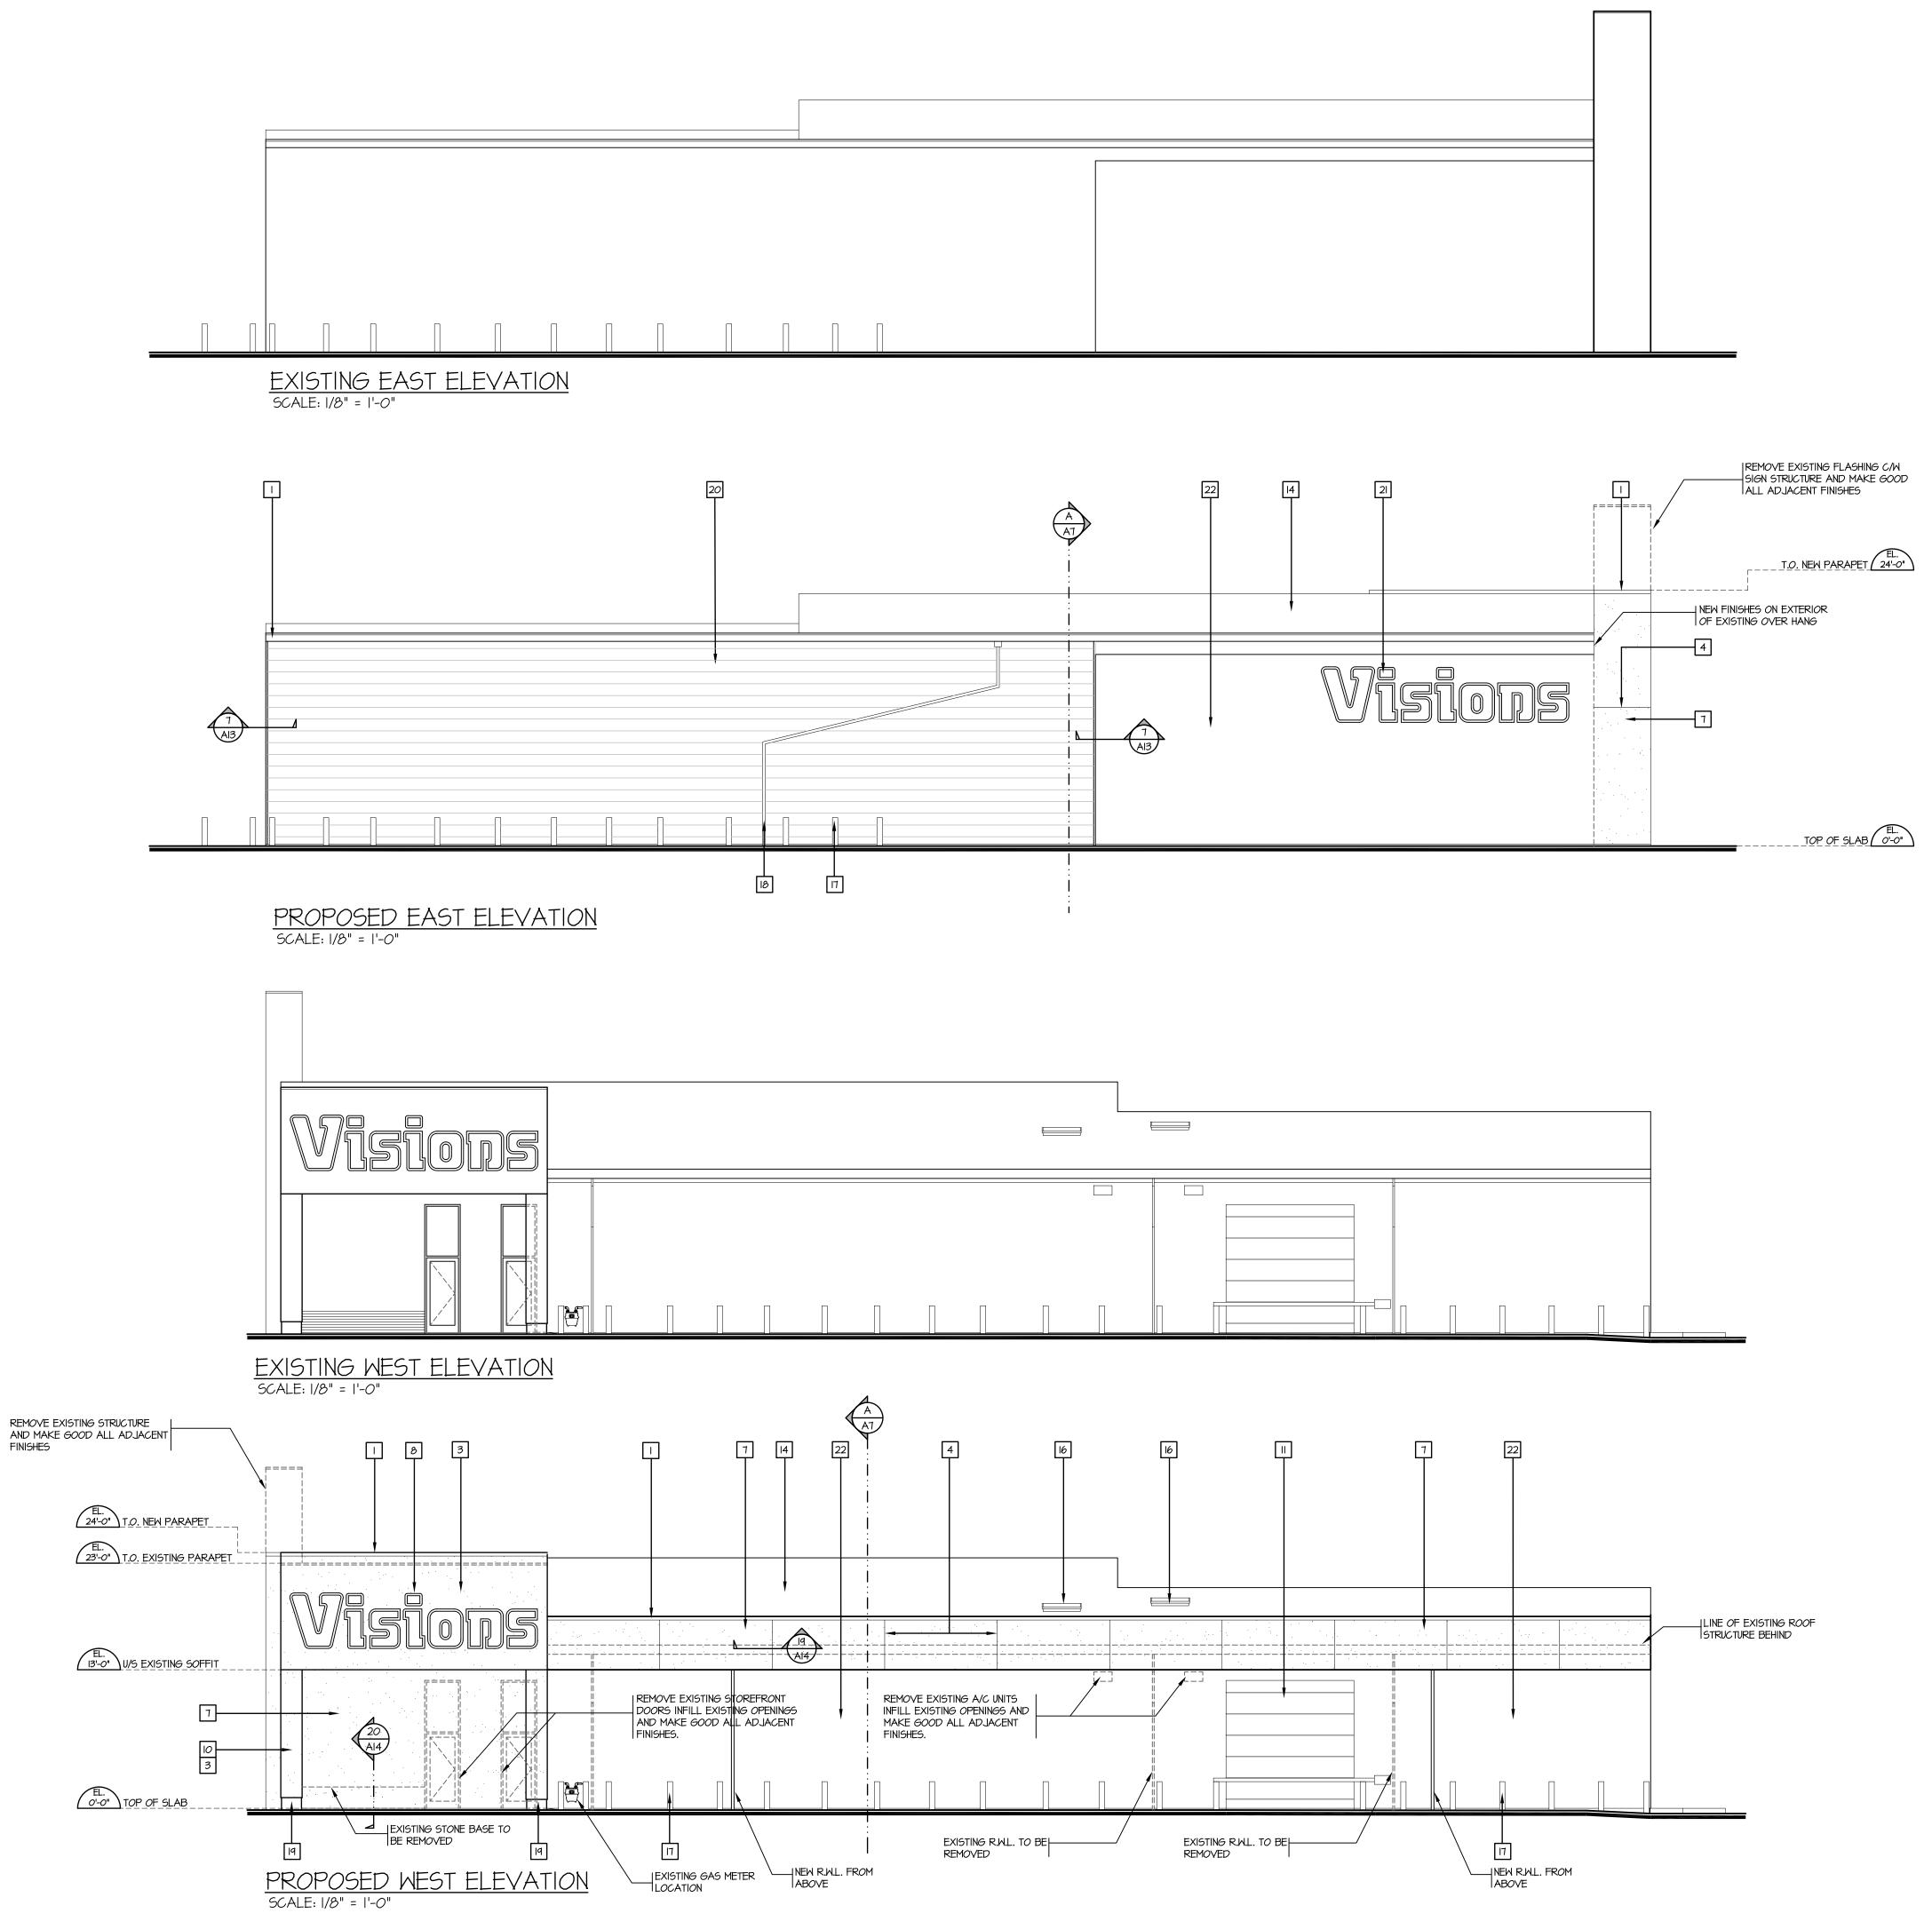

	TERIOR FINISHES Lours to be confirmed prior to painting	* ALL MATERIAL FLASHING TO BE 24 GA.
NO.	MATERIAL	COLOUR
ı	* NEW PREFINISHED METAL CAP FLASHING	RED CORAL (TO MATCH BM: R-9909)
2	EXISTING METAL FLASHING	PAINTED TO MATCH RED CORAL (TO MATCH BM: R-9909)
3	NEW STUCCO FINISH	JET BLUE (BM: CC-870)
4	NEW STUCCO REVEAL/ EXPANSION JOINT	TO MATCH ADJACENT COLOUR
5	NEW STOREFRONT WINDOW & FRAME	CLEAR ANODIZED ALUMINUM
6	NEW STOREFRONT DOOR & FRAME	CLEAR ANODIZED ALUMINUM
7	NEW STUCCO FINISH	PAINTED TO MATCH LATE WHEAT (BM: CC-240)
8	EXISTING " VISION" SIGNAGE	TO REMAIN
9	NEW " ELECTRONIC"SIGNAGE	BY SIGN SUPPLIER
Ю	EXISTING COLUMNS	JET BLUE (BM: CC-870)
II	EXISTING OVERHAED DOOR	PAINTED TO MATCH RED CORAL (TO MATCH BM: R-9909)
12	EXISTING METAL DOOR	PAINTED TO MATCH RED CORAL (TO MATCH BM: R-9909)
13	SPANDREL GLAZING	SEE NOTE:
14	EXISTING SLOPE ROOF	TO REMAIN
15	EXISTING ROOF FASCIA	TO MATCH ADJACENT COLOUR
16	EXISTING SKYLIGHT	TO REMAIN
17	EXISTING BOLLARDS	SAFETY YELLOW
18	EXISTING R.W.L.	TO REMAIN
19	EXISTING CONCRETE BASE	TO REMAIN
20	METAL SIDING - VICWEST CL435	
21	NEW " VISION" SIGNAGE	BY OWNER
22	EXISTING STUCCO FINISH	PAINTED TO MATCH LATE WHEAT (BM: CC-240)

APR. 2/13	ISSUED FOR CONSTRUCTION	
JAN. II/I3	ISSUED FOR TENDER	
DEC. 17/12	ISSUED FOR BUILDING PERMIT	
JULY 16/12	ISSUED FOR P.P.A	-
DATE	ISSUE	REV
CONSULTANT		

CONTRACTOR SHALL VERIFY ALL DIMENSIONS ON SITE. DRAWINGS SHALL NOT BE SCALED.



**AVENUE** 3707 1st BURNABY, BRITISH COLUMBIA V5C 3V6 E-MAIL: pjlovick@pjlovick.com tel: 604-298-3700 fax: 604-298-6081

Member of the SAA

Member of the AAA

Member of the AIBC Member of the RAIC Certified Professional Member of the NWTAA

SPANDREL PANEL GLAZING: EXTERIOR LITE 6mm TEMPERED GLASS 1/2" AIRSPACE INTERIOR LITE TO BE 6mm TEMPERED PPG SOLARCOOL
WITH SILVER REFLECTIVE COATING ON #3 SURFACE
BLACK SCRIM COAT TO NO. 4 SURFACE

Signs will vary to suit tenant's requirement's

and to comply with Sign by-law.

Separate permits are required.

ALL JOINTS ARE TO BE S-JOINTS, NO EXPOSED FASTENERS
PREFINISHED RED CORAL ( TO MATCH BM: R-9909 OR TO
MATCH METAL PANEL AS PER ELEVATIONS

PREFINISHED
ALTERNATIVE PRODUCTS WILL NOT BE ACCEPTED

20 METAL CLADDING: VICWEST CL435

NOTE:

METAL CAP FLASHING: 24 GAUGE

COPYRIGHT P.J. LOVICK ARCHITECT LTD. THIS MATERIAL IS AN INSTRUMENT OF SERVICE AND REMAINS AT ALL TIMES THE EXCLUSIVE PROPERTY OF P.J. LOVICK ARCHITECT LTD. REPRODUCTION OR RE-USE IS PROHIBITED WITHOUT THE WRITTEN CONSENT AND NAME OF P.J. LOVICK ARCHITECT LTD. INFORMATION SHOWN IS FOR USE ON THE DESIGNATED PROJECT ONLY. DRAWN BY PJL


**EXISTING BUILDING** 


### ALTERATION FOR VISIONS

5756 IMPERIAL STREET BURNABY, BC

BUILDING ELEVATION

PROJECT NUMBER	DRAWING NUMBER
12-18	A6
SCALE  /8" =  '-0"	
date MAR 2012	REVISION

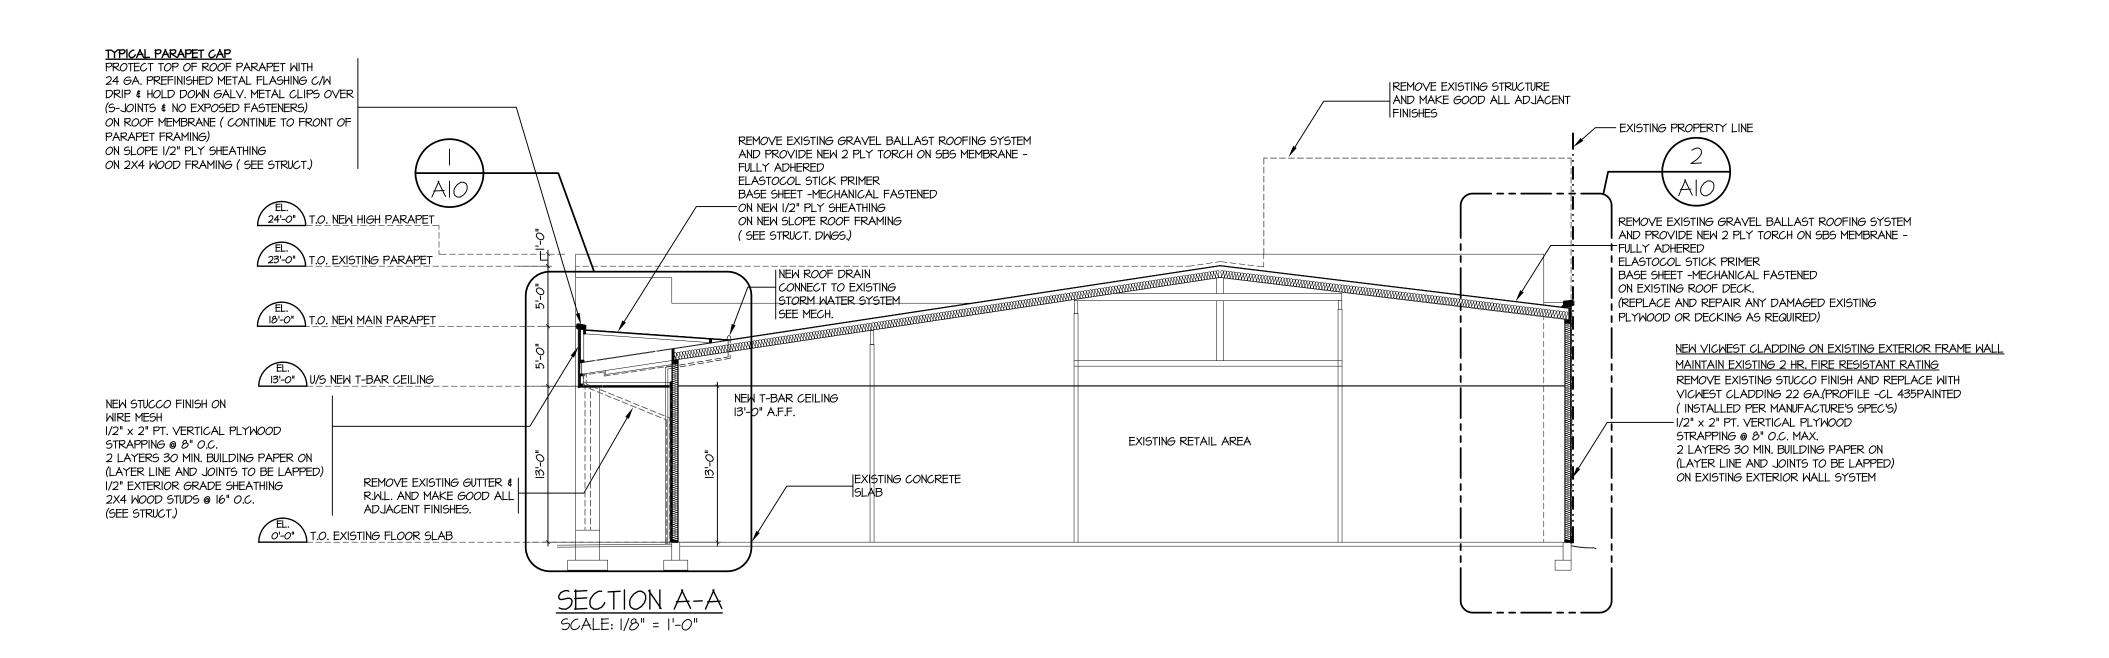

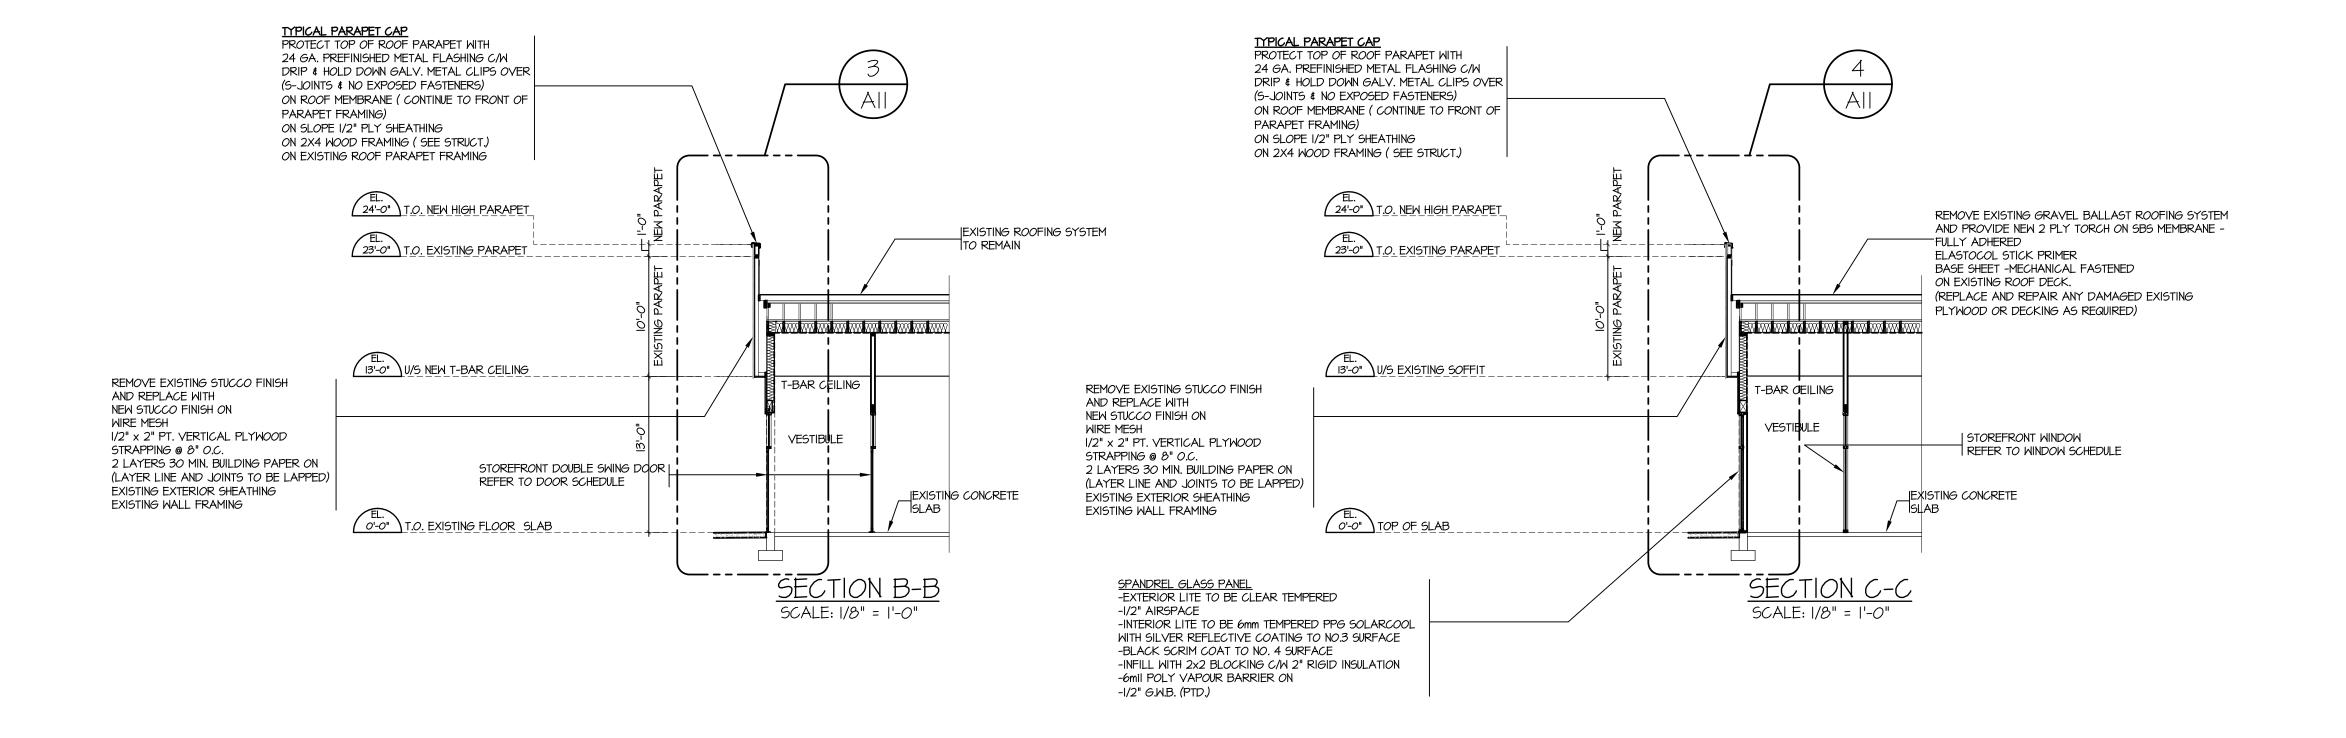

APR. 2/13	ISSUED FOR CONSTRUCTION	
JAN. II/I3	ISSUED FOR TENDER	
DEC. 17/12	ISSUED FOR BUILDING PERMIT	
JULY 16/12	ISSUED FOR PPA	-
DATE	ISSUE	REV

CONTRACTOR SHALL VERIFY ALL DIMENSIONS ON SITE. DRAWINGS SHALL NOT BE SCALED.



3707 1st AVENUE BURNABY, BRITISH COLUMBIA V5C 3V6 E-MAIL: pjlovick@pjlovick.com tel: 604-298-3700 fax: 604-298-6081

Member of the AIBC Member of the SAA
Member of the RAIC Member of the AAA
Certified Professional Member of the NWTAA
ARCHITECT SEAL

COPYRIGHT P.J. LOVICK ARCHITECT LTD. THIS MATERIAL IS AN INSTRUMENT OF SERVICE AND REMAINS AT ALL TIMES THE EXCLUSIVE PROPERTY OF P.J. LOVICK ARCHITECT LTD. REPRODUCTION OR RE-USE IS PROHIBITED WITHOUT THE WRITTEN CONSENT AND NAME OF P.J. LOVICK ARCHITECT LTD. INFORMATION SHOWN IS FOR USE ON THE DESIGNATED PROJECT ONLY. DRAWN BY

JS PJL PROJECT

# EXISTING BUILDING ALTERATION FOR VISIONS

5756 IMPERIAL STREET BURNABY, BC

DRAMING

BUILDING SECTION

PROJECT NUMBER	DRAWING NUMBER
12-18	AT
SCALE  /8" =  '-0"	
date MAR 2012	REVISION


						 D00R S	CHEDU	 LE						
NO.	SIZE	LOCATION	MATE	ERIAL			HARDH						TYPE	REMARKS
			DOOR	FRAME	R HARDWARE	THRESHOLD WEATHER STRIP KICKPLATE PUSH PLATES	LOCKSET PASSAGE SET PRIVACY SET CYLINDER LOCK	COMBINATION LOCK LOCK GUARD	DOOR STOP & HOLDER BACKCHECK CHAIN	DOOR VIEWER	PIVOT HINGES THUMB LATCH DOOR HOLDER	DOOR MITES	ו דמטון מסרו ז	GENERAL  I. INSTALL DOOR CLOSERS TO INTERIOR OF DOOR. ALL DOORS TO HAVE LEVER TYPE HANDLES U.N.O.  2. ALL DOORS TO BE ADJUSTED TO SUIT NEW FLOOR TILE LEVELS  3. EXTERIOR STOREFRONT DOORS TO BE THERMALLY BROKEN & CLEAR TEMPERED LOW 'E' GLAZING WITH SHADING COEFFICIENT OF .45.
D 101	2-3'-0" x 7'-0"	EXTERIOR TO VESTIBULE IOI	GLAZING & ALUMINUM	CLEAR ANODIZED ALUMINUM	1 4 3	3 1 1 2	1			1 1	YES	YES	1	MEDIUM STYLE 3'-0'x T-0'x I-3/4" FOR I/4" GLAZING STOREFRONT FRAMING SYSTEM TO BE KAWNEER 1600 WALL SYSTEM OR APPROVED EQUAL
D 102	2-3'-0" x 7'-0"	VESTIBULE TO SALES AREA 102	GLAZING & ALUMINUM	CLEAR ANODIZED ALUMINUM	1 4 3	3 1 1 2					YE5	YES		APPROVED MANUFACTURERS - KAWNEER, VISTAWALL, OR APPROVED EQUAL  C/W 40° RESTRICTOR
D 103	3'-0" x 6'-8"	SALES COUNTER TO OFFICE 103	SOLID CORE FIR	HOLLOW METAL (PAINTED)	2 2		2		2			YES	3	
D 104	3'-0" × 6'-8"	OFFICE TO DATA ROOM 104	SOLID CORE FIR	HOLLOW METAL (PAINTED)	2 2		2		2			YES	3	
D 105	3'-0" x 6'-8"	CAR AUDIO TO AUTO INSTALLATION II3	HOLLOW METAL - PTD.	HOLLOW METAL (PAINTED)	2 2				2			YES	2	1.5 min. F.R.R.
D 106	3'-0" x 6'-8"	CAR AUDIO TO WAREHOUSE 112	HOLLOW METAL - PTD.	HOLLOW METAL (PAINTED)	2 2				2			YES	3	
D 107	EXISTING	Existing Washroom 107	EXISTING	EXISTING									EXISTING	9
D 108	EXISTING	EXISTING WASHROOM 108	EXISTING	EXISTING									EXISTING	9
D 109	3'-0" × 6'-8"	2 EXISTING STORAGE 109	SOLID CORE FIR	EXISTING	2 2		2		2			YES	3	
1010	<del></del>	<del>/</del>						<del>                                      </del>		44			<del> </del>	<del> </del>
D III	EXISTING	CAR AUDIO TO EXISTING STAFF	EXISTING	EXISTING									EXISTING	9
D II2	(DELETED)	2												
Ell Q	EXISTING	WAERHOUSE TO EXTERIOR	2 EXISTING	EXISTING	~ <del> </del>	~ <del> </del> ~ <del> </del> ~ <del> </del> ~	<del> </del>	+		<del></del>	<del></del>	+	EXISTING	<del>)</del>
D 114	EXISTING	EXIST. CAR AUDIO INSTALLATION TO EXTERIOR	2 EXISTING	EXISTING									EXISTING	
$\rightarrow$														<del> </del> }
D 201	EXISTING	EXIST. STAIR TO EXIST. OFFICE 201	EXISTING	EXISTING									EXISTING	9
D 202	EXISTING	EXIST. OFFICE 201 TO EXIST. OFFICE 202	EXISTING	EXISTING									EXISTING	
			····-											

TYPE	NO.	
111 6	110.	PROVIDE LUG ED PALL PEARING PIETE FOR ALL CLONA 71 OF DOORS
	<u> </u>	PROVIDE I I/2 PR. BALL BEARING BUTTS FOR ALL 6'-8" & 7'-0" DOORS  MCKINNEY TA2314 4 ½" x 4" x NRP x C32D (EXTERIOR)
BUTTS	1.	-
	2.	MCKINNEY TA27I4 4 ½" x 4" x C26D (INTERIOR)
	3.	CARL VIENNA SERIES
	1.	SARGENT EN351 (REGULAR DOORS)
CL OCED	2.	SARGENT EN351-HO (HOLD OPEN)
CLOSER	3.	SARGENT EN35I-DA (DELAYED ACTION)
	4.	SARGENT ENII3I (ALUMINUM DOORS)
	l.	SARGENT 8800 (SINGLE DOORS)
PANIC HARDWARE	2.	SARGENT 8600 (DOUBLE DOORS)
	3.	SARGENT 8400/8500 (ALUMINUM DOORS)
PANIC HARDWARE TRIM		* AS FUNCTION DICTATES, CAN USE EITHER LEVER HANDLE OR PULLS AS SUPPLIED BY SARGENT
	l I.	PEMKO ITTAF
THRESHOLD	2.	PEMKO ITIA
(	3.	PEMKO 2005AV (ALIMINUM)
WEATHER STRIPING		PEMKO 319CR (JAMBS/HEADER)
712/ (11/2/ 31/ 11/ 11/ 31/ 11/ 11/ 11/ 11/ 11/ 11	2.	PEMKO 315CN (DOOR BOTTOMS)
KICK PLATES	 I.	65H 80A IO" HIGH x DOOR WIDTH LESS 2"
PUSH PLATES	i.	65H 80A 6"x20"
PULL BARS	i.	65H 46O9 x C32D
TOLL DITIO	2.	65H 166-F-C32D
	<u> </u>	SARGENT 10605-LL (OFFICE)
	2.	SARGENT 10604-LL (STORE ROOM)
LOCK SET	3.	SARGENT 10G15-3-LL (EXIT)
LOOK SET	4.	CRL PTH3IIA
	5.	5ARGENT 485 x C26D
PASSAGE SET	J.	SARGENT IOUIS-LL
PRIVACY SET	l. ''	SARGENT IOU65-LL
CYLINDER LOCK	l. ''	SARGENT CYLINDER & CAM TO SUIT APPLICATION
OTLINDER LOOK	2.	ADAMS RITE MS-1850A DEADLOCK
COMBINATION LOCK	Z·   I.	SARGENT KP-10677-LL
LOCKGUARD	'·	* SUGGEST USING ASTRAGAL STEEL OR ALUMINUM
LOOKOVAND		FASTENED SECURELY TO THE DOOR (WELDED OR
	'· 	65H 200 OR 218
DOOR STOP	2.	65H 24OB OR 25OB
		* SUGGEST USING OVERHEAD SURFACE MOUNTER OR CONCEALED STOP
DOOR STOP HOLDER	l	RIXSON #I SERIES (CONCEALED)
DOOR STOLLHOLDER	2.	RIXSON #1 SERIES (CONCEALED)  RIXSON #4 SERIES (SURFACE)
	<u> </u>	* DO NOT RECOMMEND USING, MANY ALTERNATIVES
BACKCHECK CHAIN	 	HARDWARE PRODUCTS PERFORM BETTER
DOOR ALARM	l.	#MI965 BY ANDERSON SAFES
DOOR VIEWER	'.	PEEKO DSIOOO

APR.2/13	ISSUED FOR CONSTRUCTION	<u>A</u>
MAR.12/13	ADDENDUM #2	$\triangle$
JAN. II/I3	ISSUED FOR TENDER	
DEC. 17/12	ISSUED FOR BUILDING PERMIT	
DATE	ISSUE	REV

### DOOR TYPES

MINDOW SCHEDULE

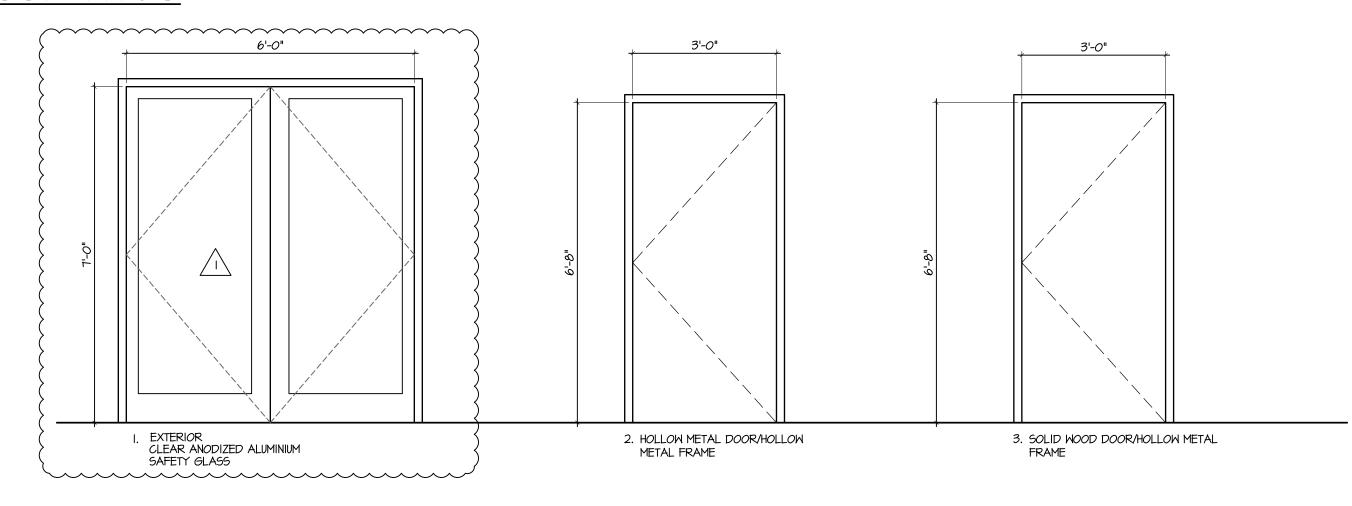

10'-0"

6'-4"

\_\_\_\_\_\_

2

EXTERIOR SELF DRAINING ALUMINUM FRAME

SPANDREL GLAZING. SEE SPECS ON A5

EXTERIOR

DOUBLE GLAZED


SELF DRAINING ALUMINUM FRAME

1'-10"

4'-0"

EXTERIOR SELF DRAINING ALUMINUM FRAME

SPANDREL GLAZING. SEE SPECS ON A5

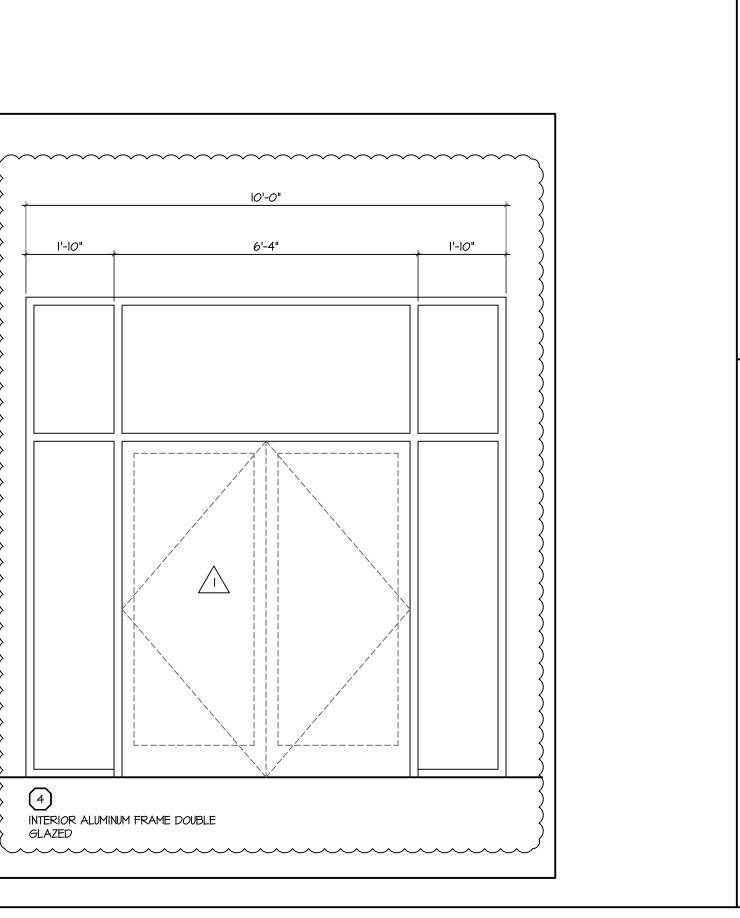



10'-0"

6'-4"

INTERIOR ALUMINUM FRAME DOUBLE

1'-10"

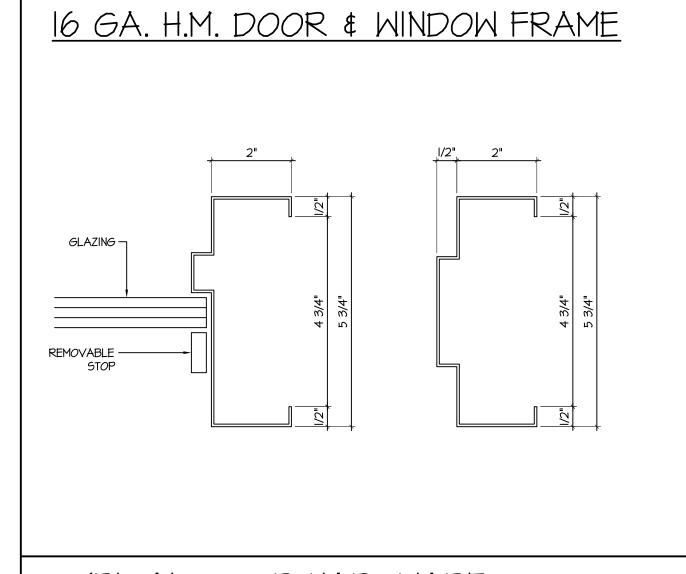

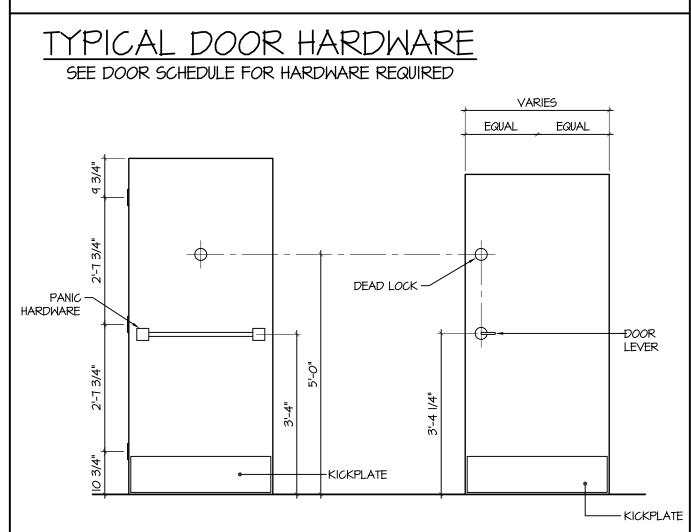

CONTRACTOR SHALL VERIFY ALL DIMENSIONS ON SITE. DRAWINGS SHALL NOT BE SCALED.



**AVENUE** BURNABY, BRITISH COLUMBIA V5C 3V6 E-MAIL: pjlovick@pjlovick.com tel: 604-298-3700 fax: 604-298-6081

Member of the AIBC Member of the SAA Member of the RAIC Certified Professional Member of the AAA Member of the NWTAA

COPYRIGHT P.J. LOVICK ARCHITECT LTD. THIS MATERIAL IS AN INSTRUMENT OF SERVICE AND REMAINS AT ALL TIMES THE EXCLUSIVE PROPERTY OF P.J. LOVICK ARCHITECT LTD. REPRODUCTION OR RE-USE IS PROHIBITED WITHOUT THE WRITTEN CONSENT AND NAME OF P.J. LOVICK ARCHITECT LTD. INFORMATION SHOWN IS FOR USE ON THE DESIGNATED PROJECT ONLY. DRAWN BY

PJL

### **EXISTING BUILDING** ALTERATION FOR VISIONS

5756 IMPERIAL STREET BURNABY, BC

DOOR/WINDOW SCHEDULES

PROJECT NUMBER DRAWING NUMBER 12-18 SCALE |/2" = |'-0" **REVISION** DEC 2012

	001	FI 000		ROOM				
	OOM NAME	FLOOR	BASE WALLS	FIN.	TYPE	INGS FIN.	HT	REMARKS * REFER TO PLANS FOR BULKHEAD LOCATION & HEIGHTS
10.	VESTIBULE	F 3, F5	M	PTI	Cl	I IIN.	<b>П</b>	-
102	SHOWROOM	FI	M	PTI	Cl		13'-0"	
103	OFFICE	F2	M	PTI	Cl		13'-0"	
104	DATA ROOM	FI	MI	PT5	Cl		13'-0"	
105	SERVICE COUNTER	FI	M	PT2, PT3	Cl		13'-0"	
106	NEW CAR AUDIO	F2	MI	PTI	Cl		13'-0"	
107	EXISTING WASHROOM		MI	PT5	EXSIT.		EXSIT.	
108	EXISTING WASHROOM	· · · · · · · · · · · · · · · · · · ·	M	PT5	EXSIT.	•	EXSIT.	
109	HIGH VALUE		WI,W2	PT5	EXSIT.		EXSIT.	
110	NEW HOME AUDIO	F2	M	PTI	Cl		13'-0"	
	EXISTING STAFF ROOM	· · · · · · · · · · · · · · · · · · ·	MI	PT5	EXSIT.	•	EXSIT.	
2	EXISTING WORKSHOP			DELETED				
113	EXISTING WAREHOUSE		WI,W2	PT5	EXSIT.		EXSIT.	
114	EXISTING AUTO INSTALLATION AREA		W2	PT5	EXSIT.		EXSIT.	
201	EXISTING OFFICE		M	PT5	EXSIT.		EXSIT.	
202	EXISTING OFFICE		M	PT5	EXSIT.		EXSIT.	

AREA	MK	MATERIAL	TYPE	MANUFACTURER SPECIFICATION
FLOOR	FI	VINYL PLANKS	D 2412 HICKORY	ARMSTRONG
	F 2	VINYL PLANKS	D 2413 HICKORY	ARMSTRONG
	F 3	VINYL	TERRA TURF	JOHNSONITE
	F 4			
	F5	VINYL	CASCADE CERAMICS	TEXAS - CAPRO CK
BASE	ВІ	WOOD	4" BASEBOARD	-
DMJL	B 2	TILE	CUT-TILE BASE	TO MATCH FLOOR TILE
	В3	VINYL COVE	4" CONTINUOUS COVE, (BLACK)	-
WALLS	МІ	I/2" GYPSUM WALLBOARD	STANDARD WALLBOARD	_
	W 2	5/8" 'TYPE-X' GYPSUM WALLBOARD	FIRE RATED	-
CEILINGS	C 1	2'x 4'x I/2" ACCOUSTICAL TILE)/\	SUSPENDED GRID SYSTEM	ARMSTRONG CORTEGA #769
	62	NEW GYPSUM BOARD CEILING	PAINTED	
	<i>C</i> 3	NEW IHR. FIRE RATED TYPE 'X' CEILING	FIRE RATED	
	C4	EXPOSED BEAMS / EXPOSED FRAMING	PTD.	
	<i>C</i> 5	1/2" GYPSUM WALLBOARD	REGULAR WALLBOARD	
FINISH	PTI	PAINT	IO-IO GOLDEN TAN	PRATT & LAMBERT
	PT2	PAINT	IO-13 GOLDEN TAN	-
	PT3		22-20 GOLDEN TAN	-
	PT4		31-17 GOLDEN TAN	-
	PT5	PAINT	IO-2 GOLDEN TAN	-
				-
				-

APR.2/13	ISSUED FOR CONSTRUCTION	$\triangle$
JAN. II/I3	ISSUED FOR TENDER	
DEC. 17/12	ISSUED FOR BUILDING PERMIT	
DATE	ISSUE	REV
CONSULTANT		•

CONTRACTOR SHALL VERIFY ALL DIMENSIONS ON SITE. DRAWINGS SHALL NOT BE SCALED.

### P J L OVICK ARCHITECT LTD

3707 1st AVENUE BURNABY, BRITISH COLUMBIA V5C 3V6 E-MAIL: pjlovick@pjlovick.com tel: 604-298-3700 fax: 604-298-6081

Member of the AIBC Member of the RAIC Certified Professional ARCHITECT SEAL Member of the SAA Member of the AAA Member of the NWTAA

COPYRIGHT P.J. LOVICK ARCHITECT LTD. THIS MATERIAL IS AN INSTRUMENT OF SERVICE AND REMAINS AT ALL TIMES THE EXCLUSIVE PROPERTY OF P.J. LOVICK ARCHITECT LTD. REPRODUCTION OR RE-USE IS PROHIBITED WITHOUT THE WRITTEN CONSENT AND NAME OF P.J. LOVICK ARCHITECT LTD. INFORMATION SHOWN IS FOR USE ON THE DESIGNATED PROJECT ONLY. DRAWN BY

JS PJL
PROJECT

# EXISTING BUILDING ALTERATION FOR VISIONS

5756 IMPERIAL STREET BURNABY, BC

DRAWING


ROOM FINISH SCHEDULES


DRAWING NUMBER
A9
REVISION

NOTES:

COLUMNS TO BE: PT2 (TYP.)
BULKHEADS TO BE: PT4 (TYP.)

ALL EXPOSED DECK, DUCTWORK, METAL TO BE: PT2 (TYP.)

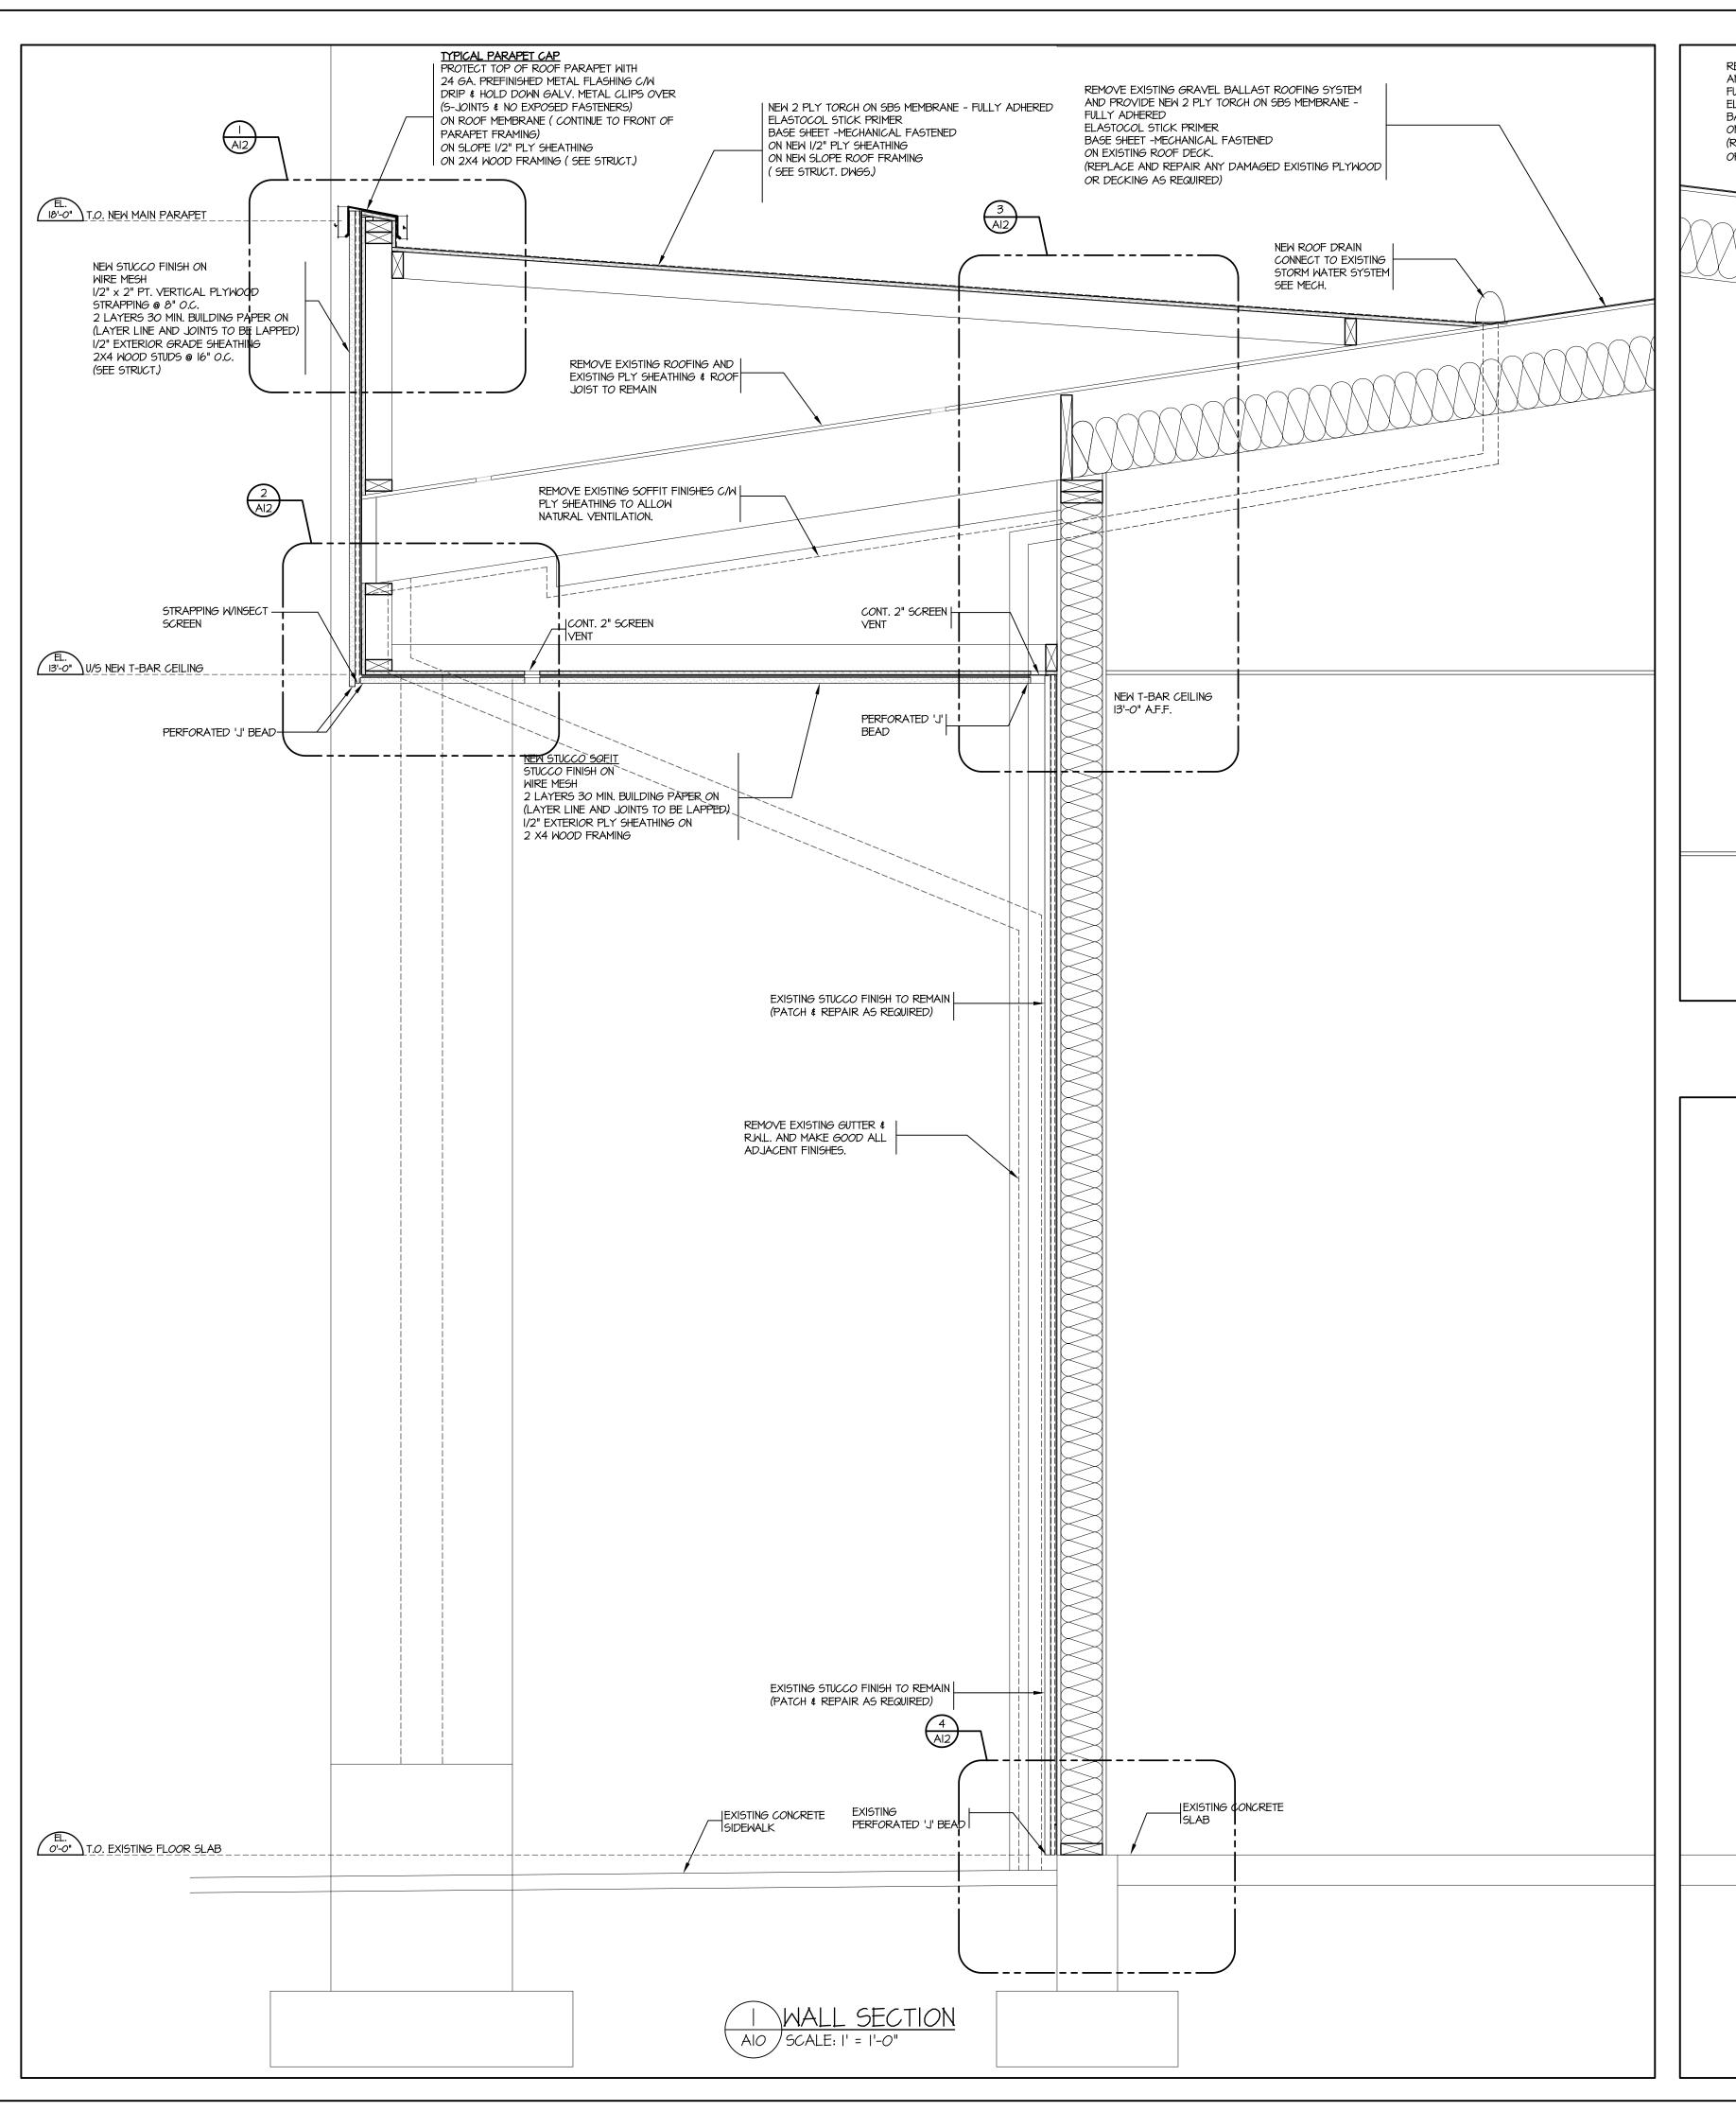

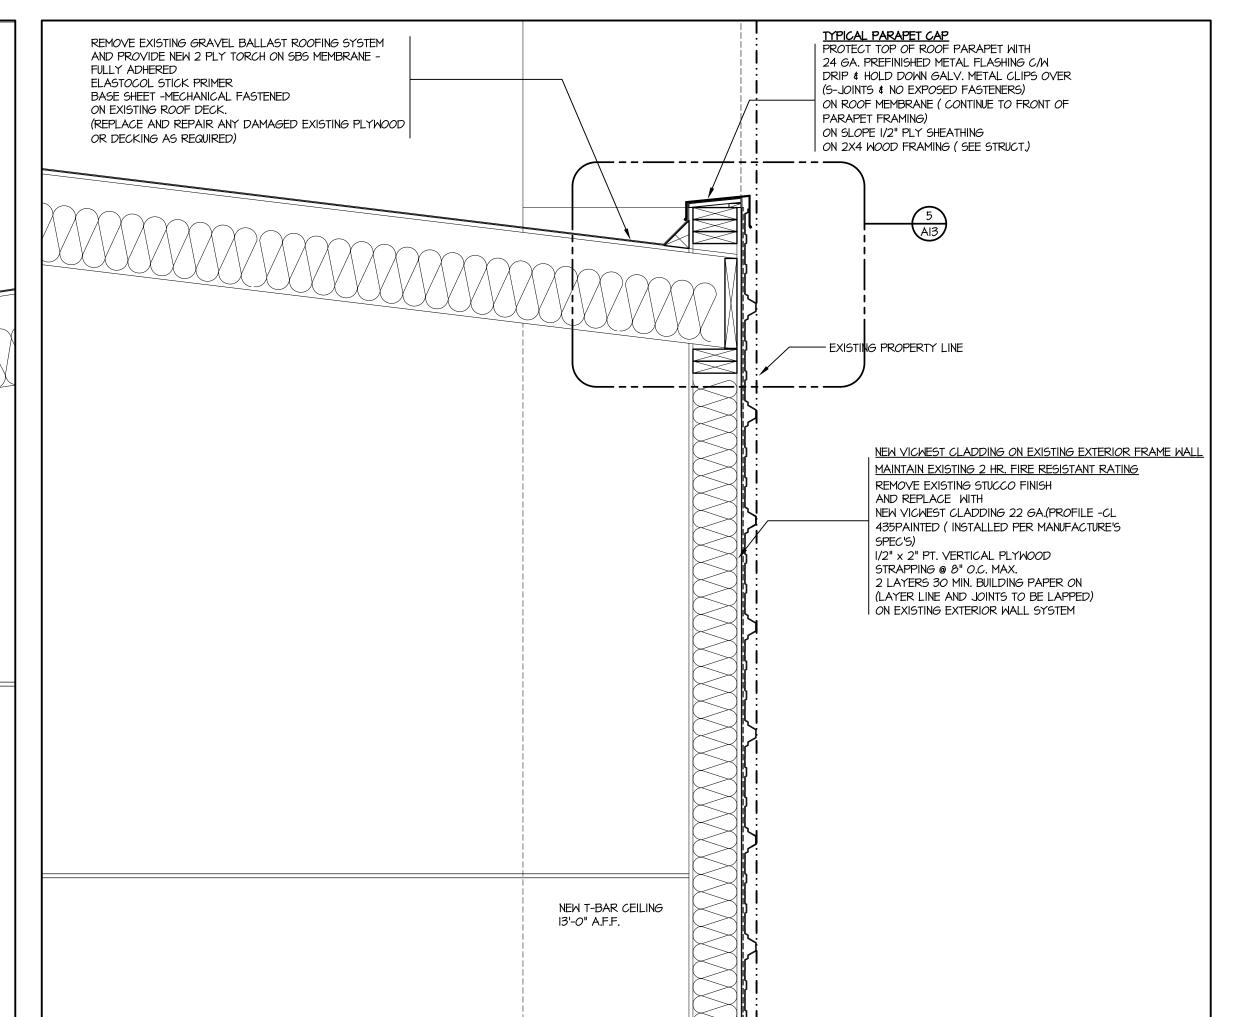

APR. 2/13	ISSUED FOR CONSTRUCTION	
JAN. II/I3	ISSUED FOR TENDER	
DEC. 17/12	ISSUED FOR BUILDING PERMIT	
JULY 16/12	ISSUED FOR PPA	-
DATE	ISSUE	REV
CONSULTANT		

CONTRACTOR SHALL VERIFY ALL DIMENSIONS ON SITE. DRAWINGS SHALL NOT BE SCALED.

### PILOVICK ARCHITECT LTD

**AVENUE** 1st BURNABY, BRITISH COLUMBIA V5C 3V6 E-MAIL: pjlovick@pjlovick.com fax: 604-298-6081 tel: 604-298-3700

Member of the AIBC Member of the RAIC Certified Professional

NEW VICWEST CLADDING ON EXISTING EXTERIOR FRAME WALL

MAINTAIN EXISTING 2 HR. FIRE RESISTANT RATING

AND REPLACE WITH

NEW VICWEST CLADDING 22 GA.(PROFILE -CL 435PAINTED (INSTALLED PER MANUFACTURE'S

REMOVE EXISTING STUCCO FINISH

I/2" x 2" PT. VERTICAL PLYWOOD STRAPPING @ 8" O.C. MAX. 2 LAYERS 30 MIN. BUILDING PAPER ON (LAYER LINE AND JOINTS TO BE LAPPED) ON EXISTING EXTERIOR WALL SYSTEM

STRAPPING WINSECT

| CHANNEL OLOSURE TO | MATCH PANEL COLOUR.

J PREFINISH**T**D 24 6A. METAL

HEAD FLASHING C/W DRIP EDGE

AIO / SCALE: |' = |'-0"

SCREEN

EXISTING CONCRETESLAB

Member of the SAA Member of the AAA Member of the NWTAA ARCHITECT SEAL


COPYRIGHT P.J. LOVICK ARCHITECT LTD. THIS MATERIAL IS AN INSTRUMENT OF SERVICE AND REMAINS AT ALL TIMES THE EXCLUSIVE PROPERTY OF P.J. LOVICK ARCHITECT LTD. REPRODUCTION OR RE-USE IS PROHIBITED WITHOUT THE WRITTEN CONSENT AND NAME OF P.J. LOVICK ARCHITECT LTD. INFORMATION SHOWN IS FOR USE ON THE DESIGNATED PROJECT ONLY.


### **EXISTING BUILDING** ALTERATION FOR VISIONS


5756 IMPERIAL STREET BURNABY, BC


WALL SECTIONS


PROJECT NUMBER	DRAWING NUMBER
12-18	AlO
9CALE  " =  '-0"	
date MAR 2012	REVISION

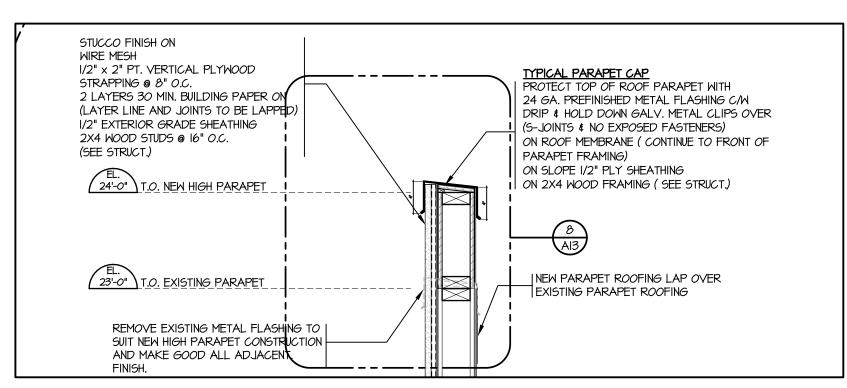


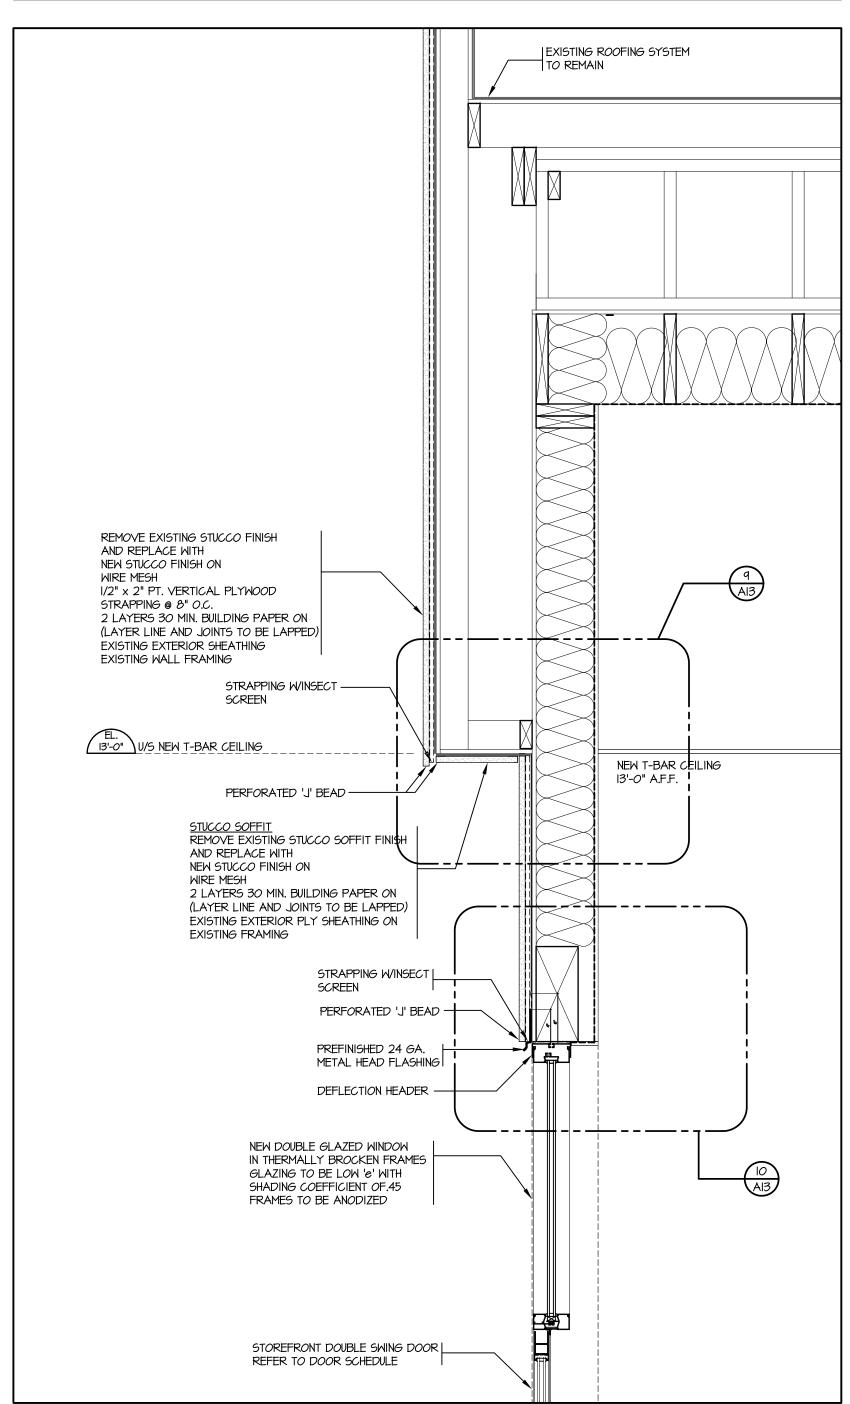

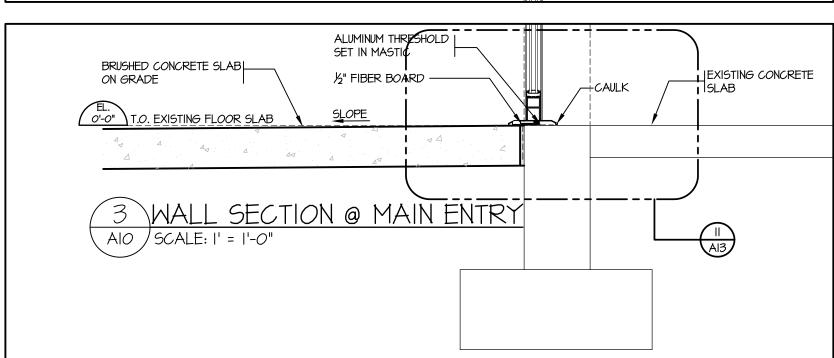

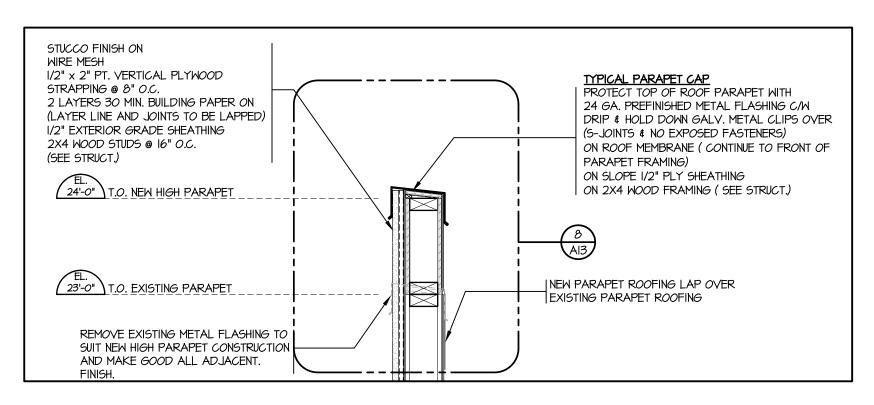

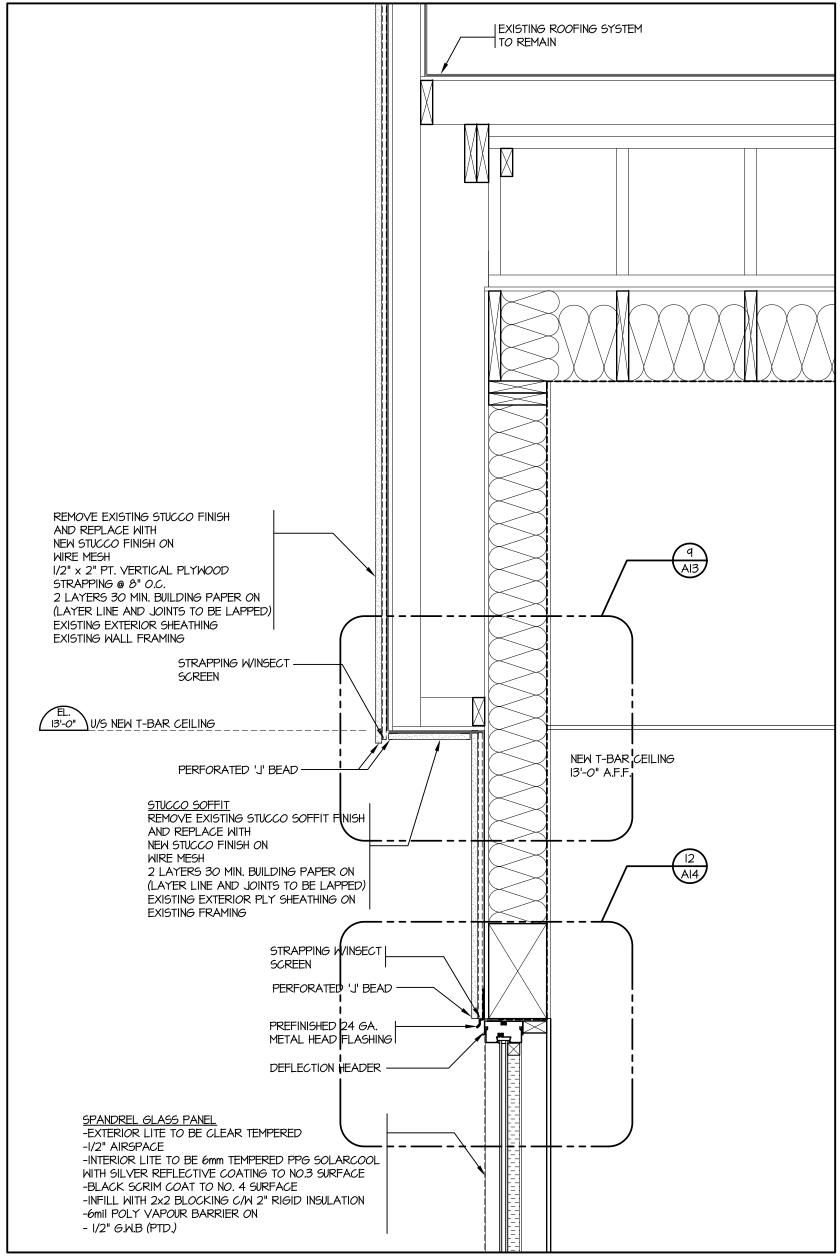

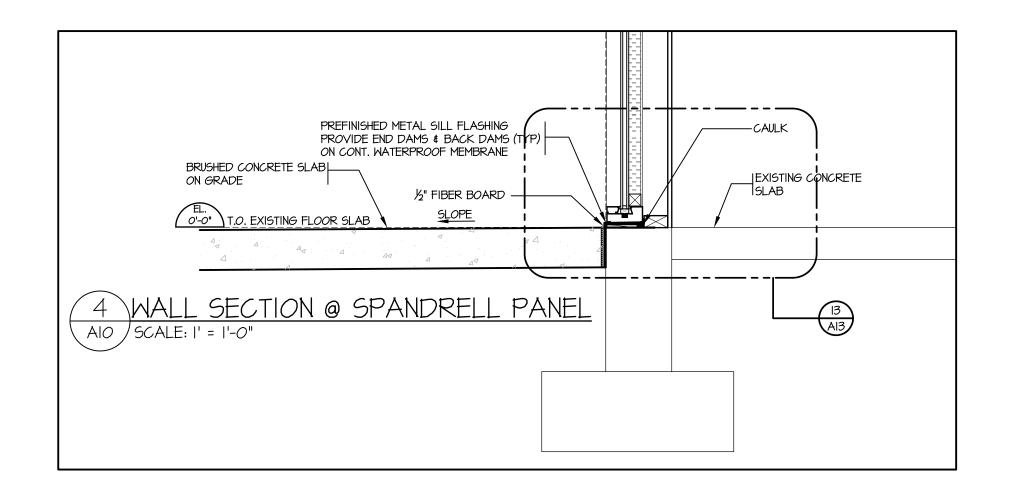

APR. 2/13	ISSUED FOR CONSTRUCTION	
Jan. II/I3	ISSUED FOR TENDER	
DEC. 17/12	ISSUED FOR BUILDING PERMIT	
JULY 16/12	ISSUED FOR PPA	-
DATE	ISSUE	REV
CONSULTANT		•

CONTRACTOR SHALL VERIFY ALL DIMENSIONS ON SITE. DRAWINGS SHALL NOT BE SCALED.



3707 1st AVENUE BURNABY, BRITISH COLUMBIA V5C 3V6 E-MAIL: pjlovick@pjlovick.com tel: 604-298-3700 fax: 604-298-6081

Member of the AIBC
Member of the RAIC
Certified Professional
ARCHITECT SEAL

Member of the SAA Member of the AAA Member of the NWTAA

COPYRIGHT P.J. LOVICK ARCHITECT LTD. THIS MATERIAL IS AN INSTRUMENT OF SERVICE AND REMAINS AT ALL TIMES THE EXCLUSIVE PROPERTY OF P.J. LOVICK ARCHITECT LTD. REPRODUCTION OR RE-USE IS PROHIBITED WITHOUT THE WRITTEN CONSENT AND NAME OF P.J. LOVICK ARCHITECT LTD. INFORMATION SHOWN IS FOR USE ON THE DESIGNATED PROJECT ONLY. DRAWN BY

JS PJL
PROJECT


# EXISTING BUILDING ALTERATION FOR VISIONS

5756 IMPERIAL STREET BURNABY, BC


DRAWING

WALL SECTIONS


PROJECT NUMBER	DRAWING NUMBER
12-18	All
SCALE  " =  '-0"	
date MAR 2012	REVISION

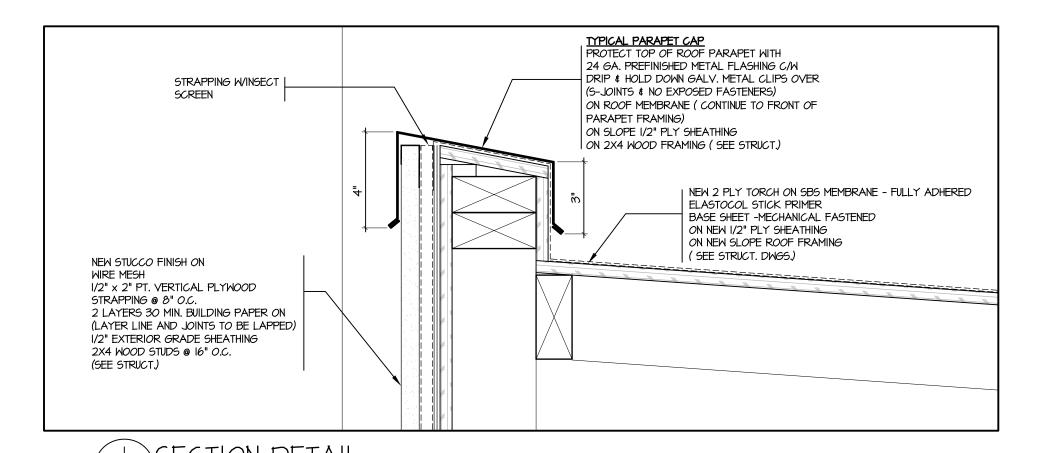

PROVIDE I VENT PER ROOF JOIST CAVITY. (TYPICAL) NEW STUCCO FINISH ON WIRE MESH 1/2" x 2" PT. VERTICAL PLYWOOD STRAPPING @ 8" O.C. 2 LAYERS 30 MIN. BUILDING PAPER ON (LAYER LINE AND JOINTS TO BE LAPPED) 1/2" EXTERIOR GRADE SHEATHING 2X4 WOOD STUDS @ 16" O.C. (SEE STRUCT.) REMOVE EXISTING SOFFIT FINISHES C/W PLY SHEATHING TO ALLOW NATURAL VENTILATION. CONT. 2" SCREEN
VENT STRAPPING WINSECT L SCREEN PERFORATED 'J' BEAD NEW STUCCO SOFIT STUCCO FINISH ON WIRE MESH 2 LAYERS 30 MIN. BUILDING PAPER ON (LAYER LINE AND JOINTS TO BE LAPPED)
1/2" EXTERIOR PLY SHEATHING ON
2 X4 WOOD FRAMING

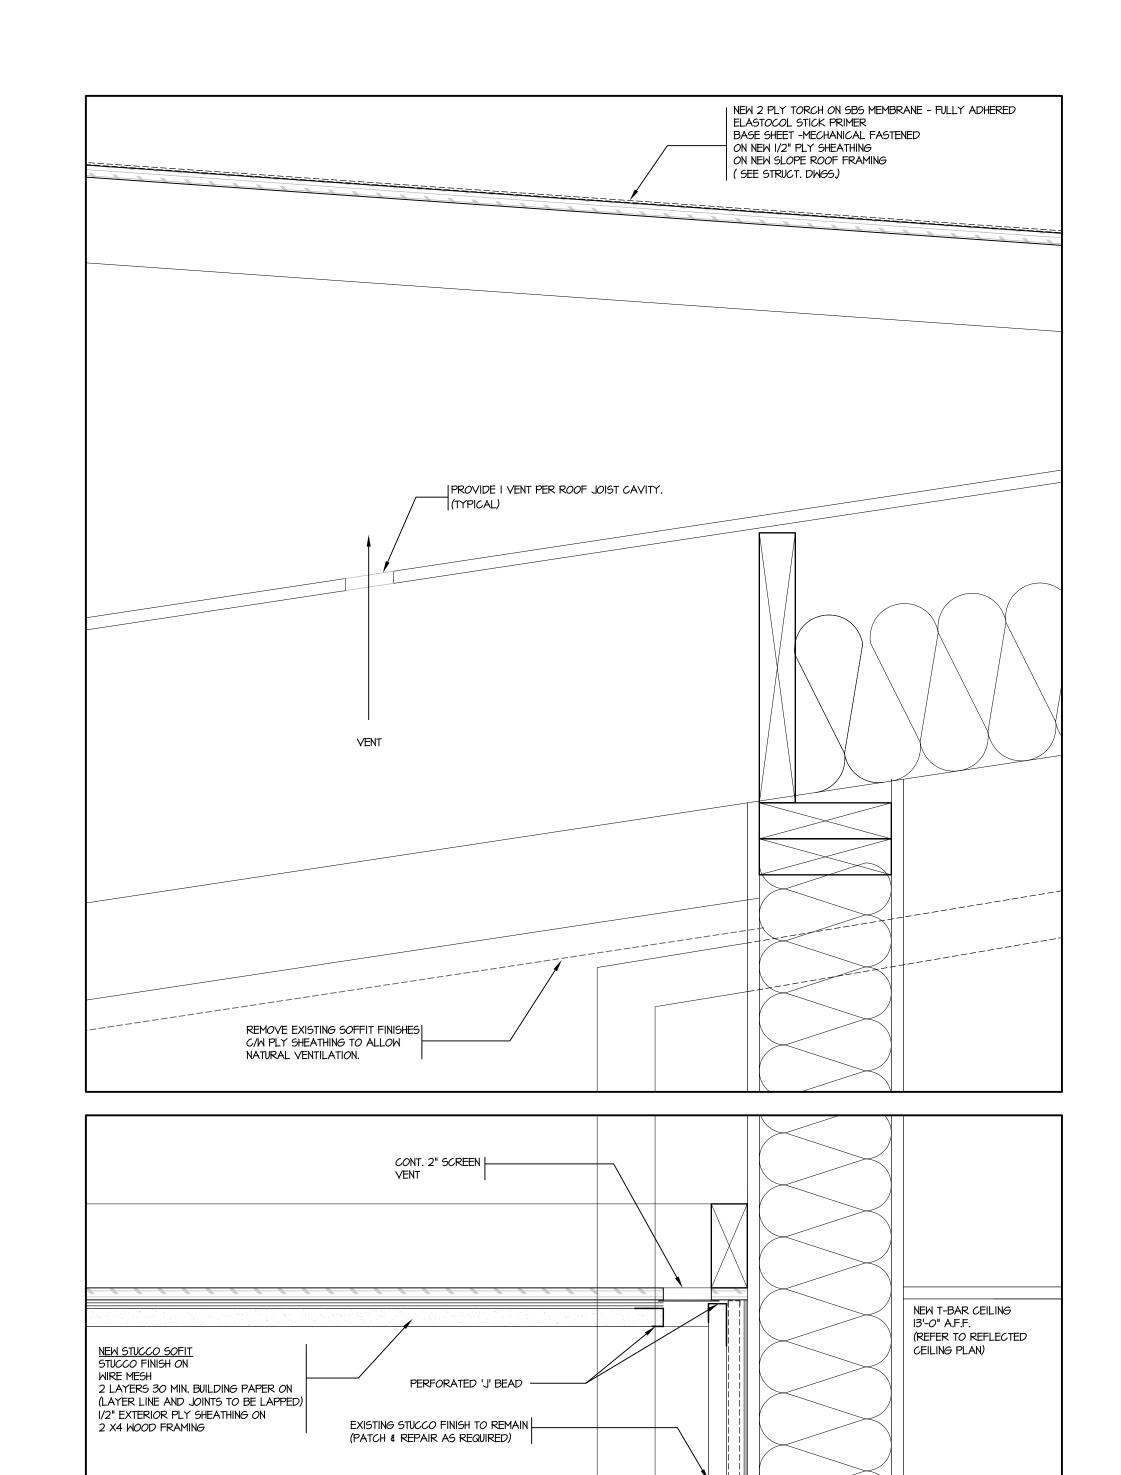



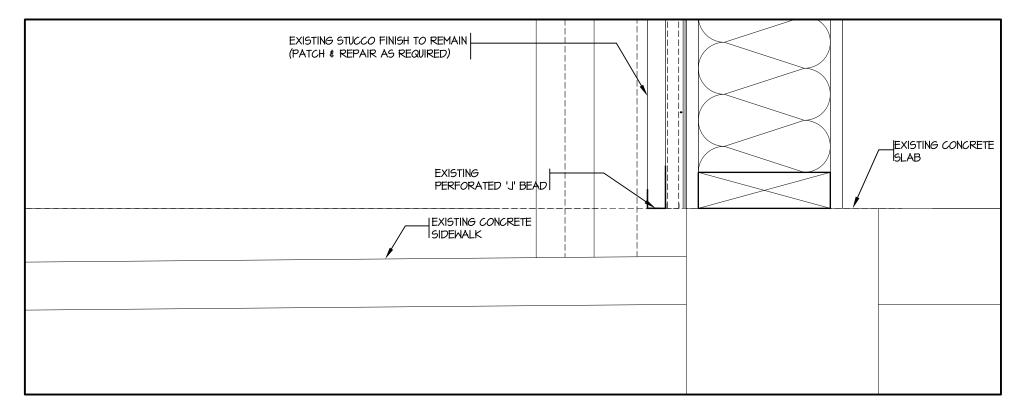



APR. 2/13	ISSUED FOR CONSTRUCTION	
JAN. II/I3	ISSUED FOR TENDER	
DEC. 17/12	ISSUED FOR BUILDING PERMIT	
JULY 16/12	ISSUED FOR PPA	-
DATE	ISSUE	REV
CONSULTANT		

CONSULTANT SEAL

CONTRACTOR SHALL VERIFY ALL DIMENSIONS ON SITE. DRAWINGS SHALL NOT BE SCALED.



3707 **AVENUE** BURNABY, BRITISH COLUMBIA V5C 3V6 E-MAIL: pjlovick@pjlovick.com tel: 604-298-3700 fax: 604-298-6081 Member of the SAA Member of the AAA Member of the NWTAA

Member of the AIBC Member of the RAIC Certified Professional ARCHITECT SEAL

COPYRIGHT P.J. LOVICK ARCHITECT LTD. THIS MATERIAL IS AN INSTRUMENT OF SERVICE AND REMAINS AT ALL TIMES THE EXCLUSIVE PROPERTY OF P.J. LOVICK ARCHITECT LTD. REPRODUCTION OR RE-USE IS PROHIBITED WITHOUT THE WRITTEN CONSENT AND NAME OF P.J. LOVICK ARCHITECT LTD. INFORMATION SHOWN IS FOR USE ON THE DESIGNATED PROJECT ONLY. DRAWN BY APPROVED


PJL


### **EXISTING BUILDING** ALTERATION FOR VISIONS


5756 IMPERIAL STREET BURNABY, BC

SECTION DETAILS


PROJECT NUMBER	DRAWING NUMBER
12-18	Al2
SCALE  " =  '-O"	
DATE DEC 2012	REVISION

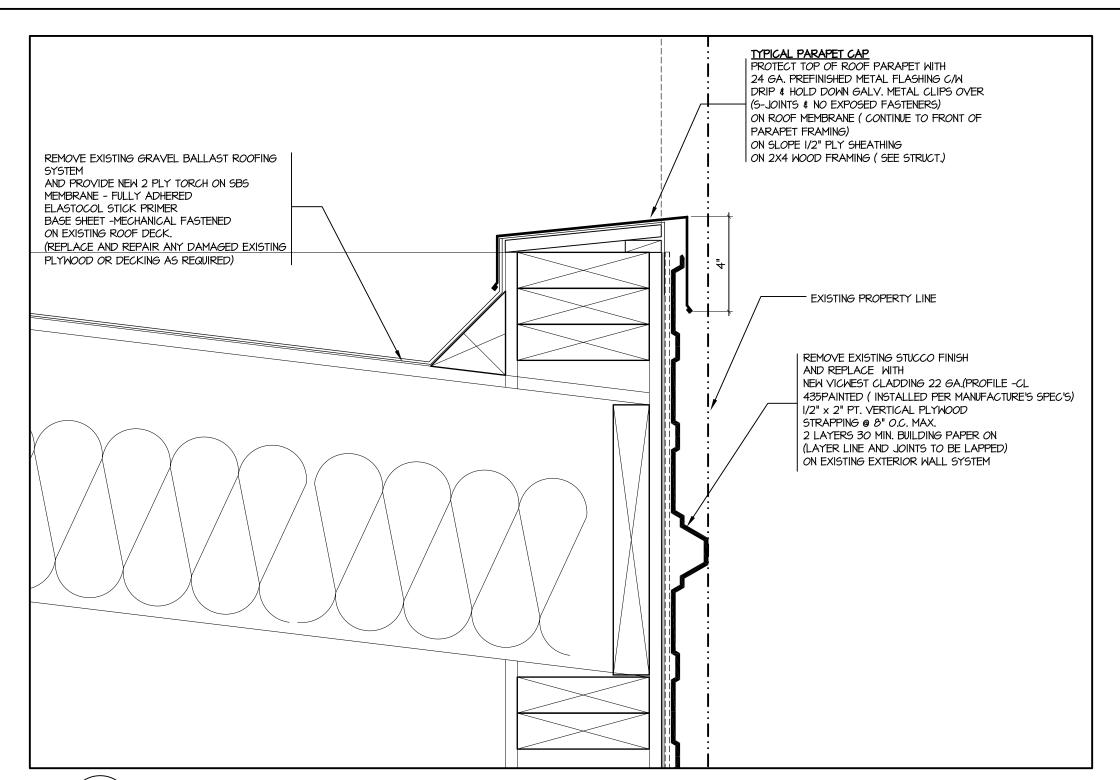

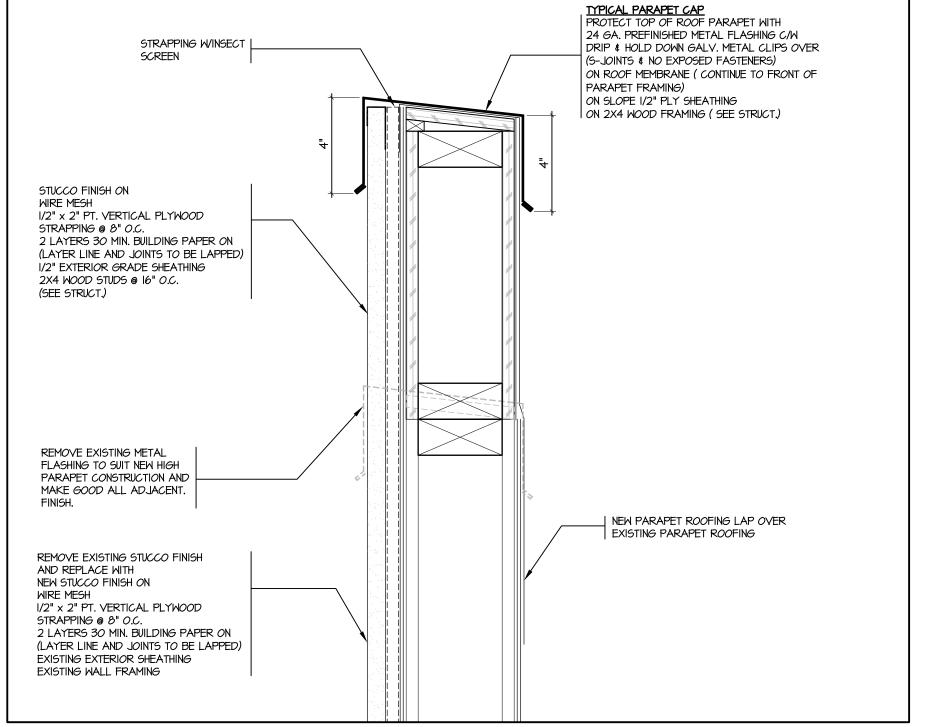

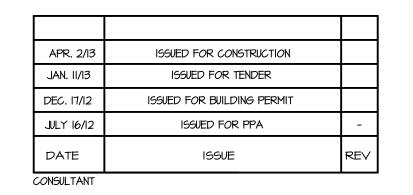

### 8 SECTION DETAIL

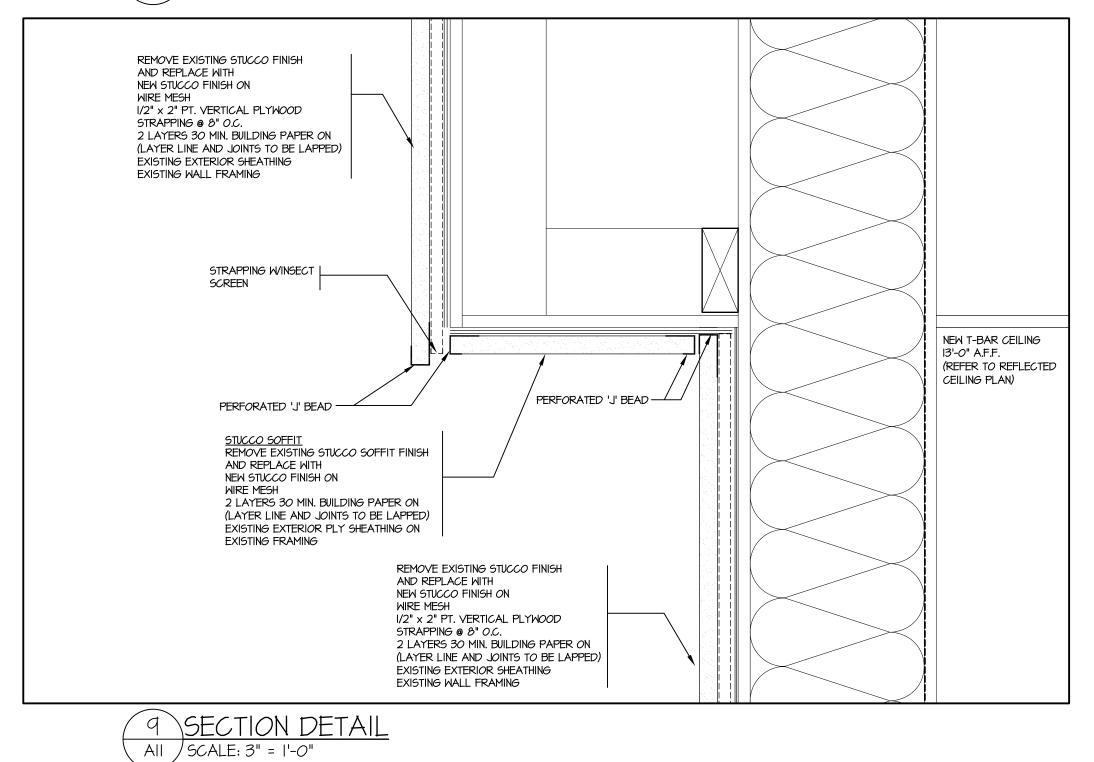

DRAWINGS SHALL NOT BE SCALED.

CONSULTANT SEAL



CONTRACTOR SHALL VERIFY ALL DIMENSIONS ON SITE.

3707 **AVENUE** BURNABY, BRITISH COLUMBIA V5C 3V6 E-MAIL: pjlovick@pjlovick.com fax: 604-298-6081 tel: 604-298-3700

ARCHITECT SEAL

Member of the SAA Member of the AIBC Member of the RAIC Member of the AAA Member of the NWTAA Certified Professional

COPYRIGHT P.J. LOVICK ARCHITECT LTD. THIS MATERIAL IS AN INSTRUMENT OF SERVICE AND REMAINS AT ALL TIMES THE EXCLUSIVE PROPERTY OF P.J. LOVICK ARCHITECT LTD. REPRODUCTION OR RE-USE IS PROHIBITED WITHOUT THE WRITTEN CONSENT AND NAME OF P.J. LOVICK ARCHITECT LTD. INFORMATION SHOWN IS FOR USE ON THE DESIGNATED PROJECT ONLY.

APPROVED

PJL

### **EXISTING BUILDING**

ALTERATION FOR VISIONS 5756 IMPERIAL STREET

BURNABY, BC

DRAWN BY

SECTION DETAILS


PROJECT NUMBER DRAWING NUMBER Al3 12-18 SCALE |" = |'-0" DATE **REVISION** DEC 2012


AND REPLACE WITH NEW VICWEST CLADDING 22 GA.(PROFILE -CL 435PAINTED (INSTALLED PER MANUFACTURE'S SPEC'S) 1/2" x 2" PT. VERTICAL PLYWOOD STRAPPING @ 8" O.C. MAX. 2 LAYERS 30 MIN. BUILDING PAPER ON (LAYER LINE AND JOINTS TO BE LAPPED) ON EXISTING EXTERIOR WALL SYSTEM —STRAPPING WINSECT SCREEN EXISTING CONCRETE -CHANNEL CLOSURE TO MATCH PANEL COLOUR. - PREFINISHED 24 GA. METAL HEAD FLASHING C/W DRIP EDGE


| REMOVE EXISTING STUCCO FINISH

6 SECTION DETAIL
AIO SCALE: 3" = 1'-0"

AIO / SCALE: 3" = 1'-0"

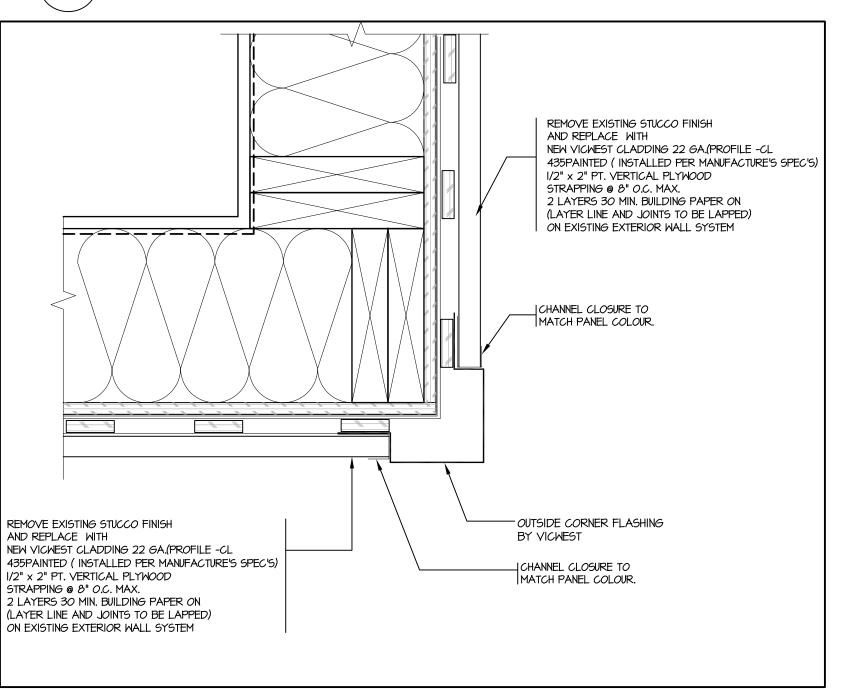

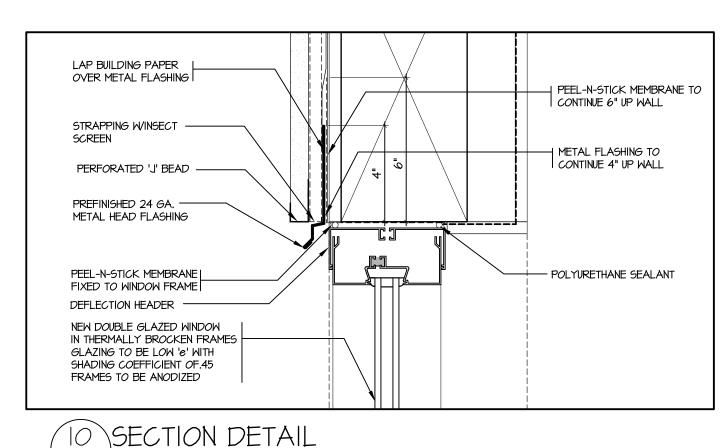

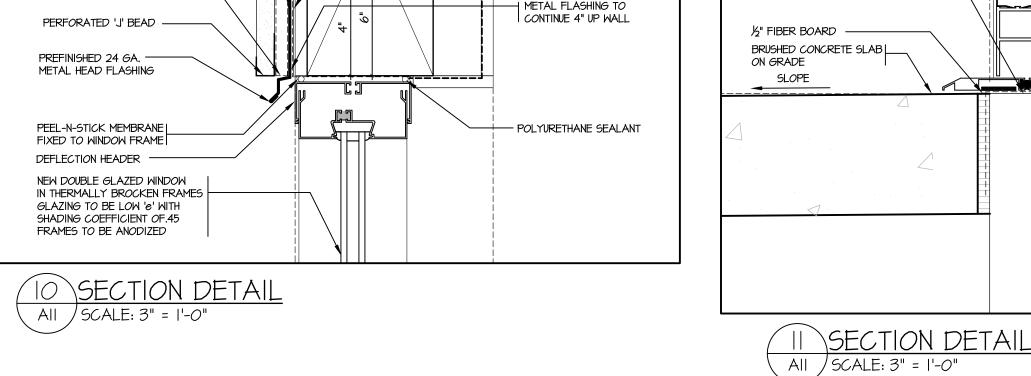

STOREFRONT DOUBLE SWING DOOR |

/—CAULK


- EXISTING CONCRETE

SLAB


REFER TO DOOR SCHEDULE

ALUMINUM THRESHOLD SET IN -

PLAN DETAIL @90° CORNER

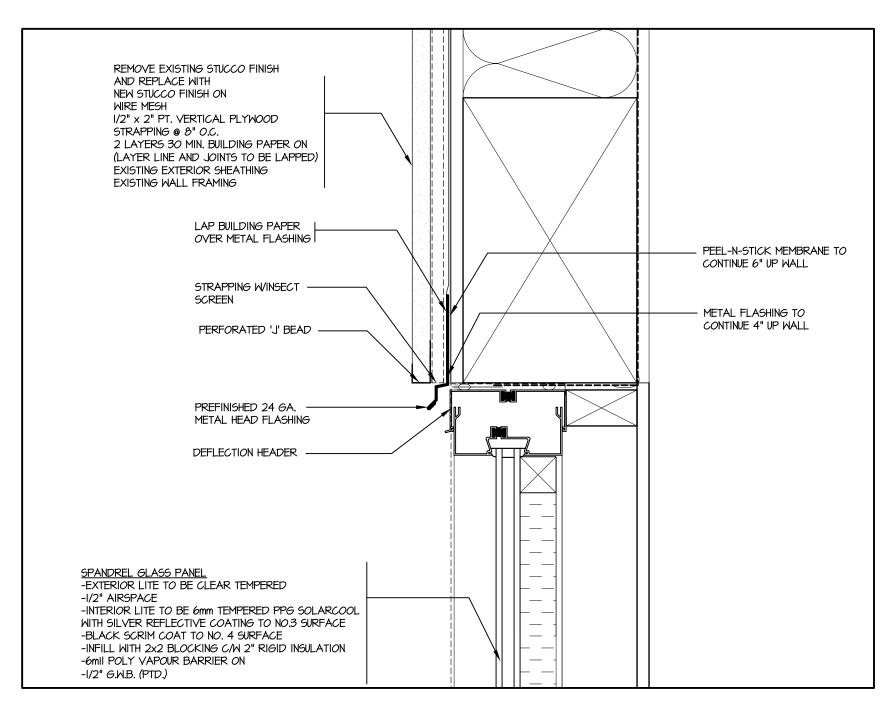


SECTION DETAIL
SCALE: 3" = 1'-0"

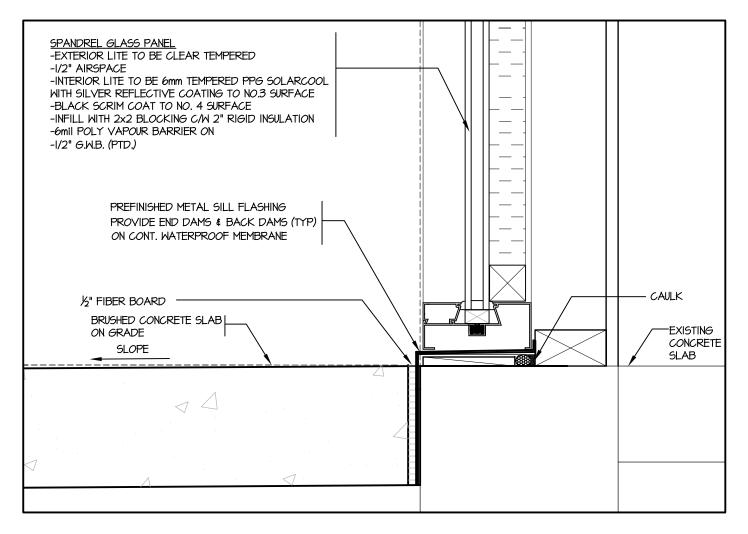


SECTION DETAIL


AII SCALE: 3" = 1'-0"

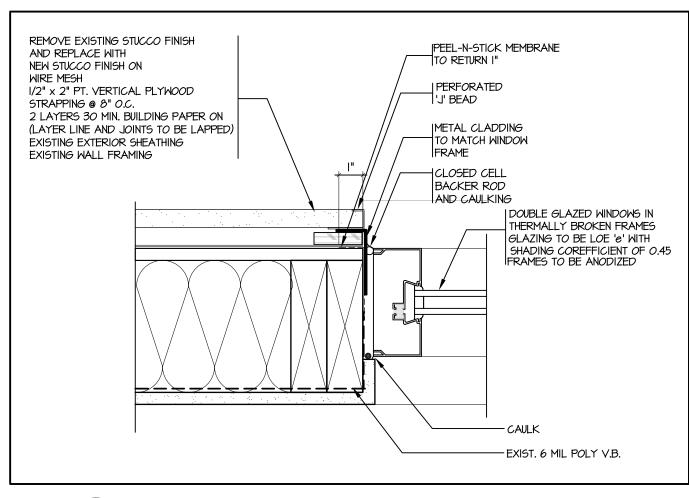


14 SECTION DETAIL
All SCALE: 3" = 1'-0"

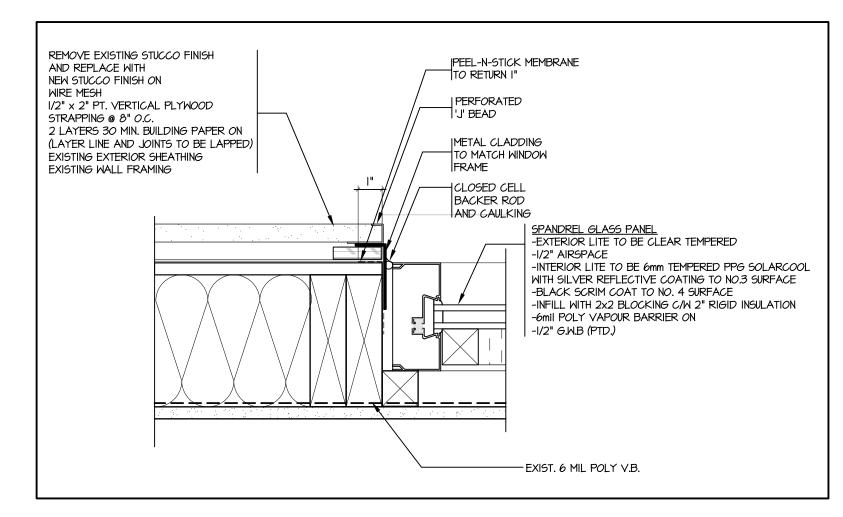

15 SECTION DETAIL
All SCALE: 3" = 1'-0"

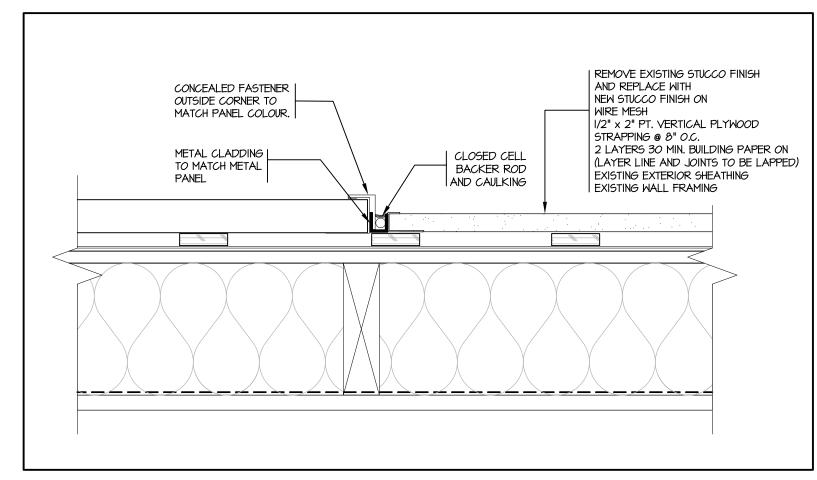


16 PLAN DETAIL @ STUCCO JOINT/METAL CLADDING
A2 SCALE: 3" = 1'-0"

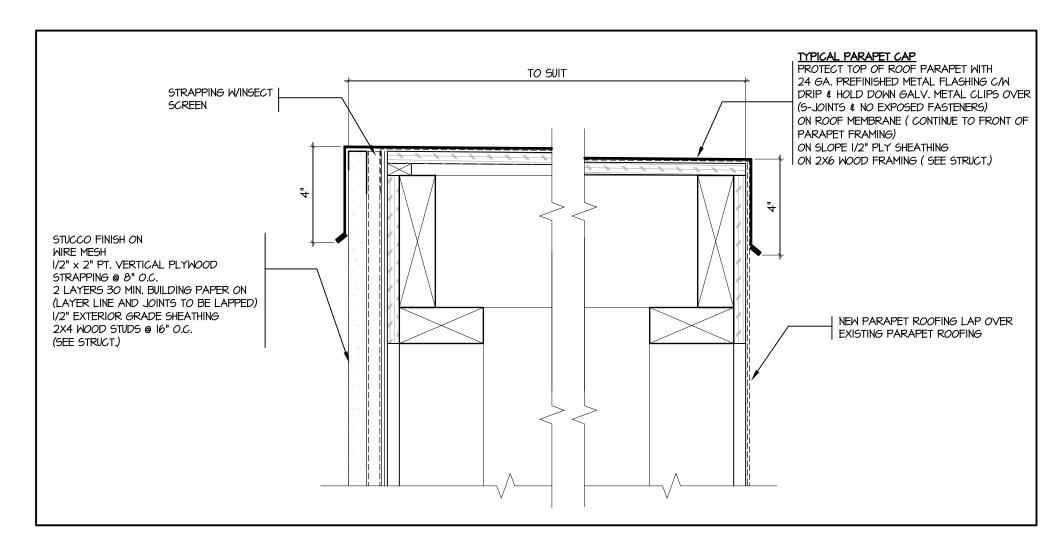


SECTION DETAIL


A4 SCALE: 3" = 1'-0"

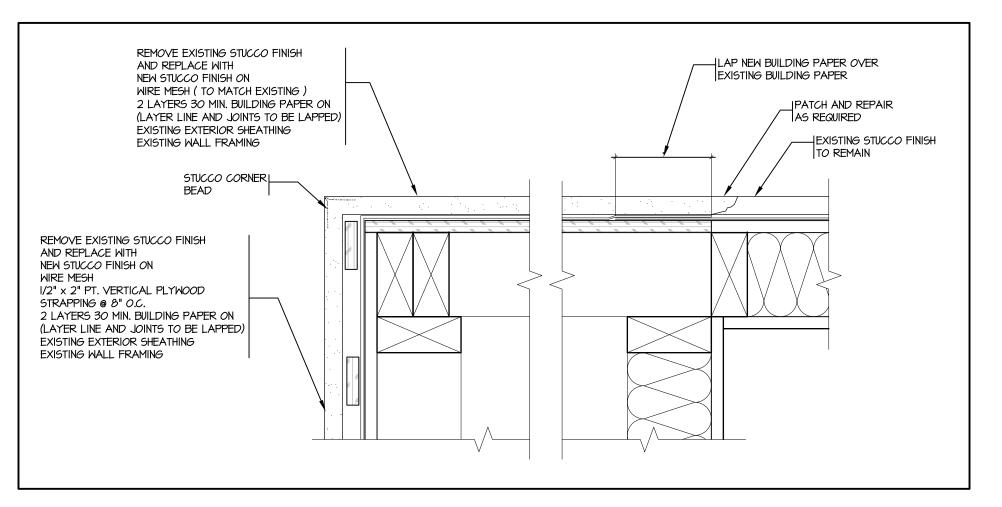

18 PLAN DETAIL NEW STUCCO @ EXISTING STUCCO A2 SCALE: 3" = 1'-0"

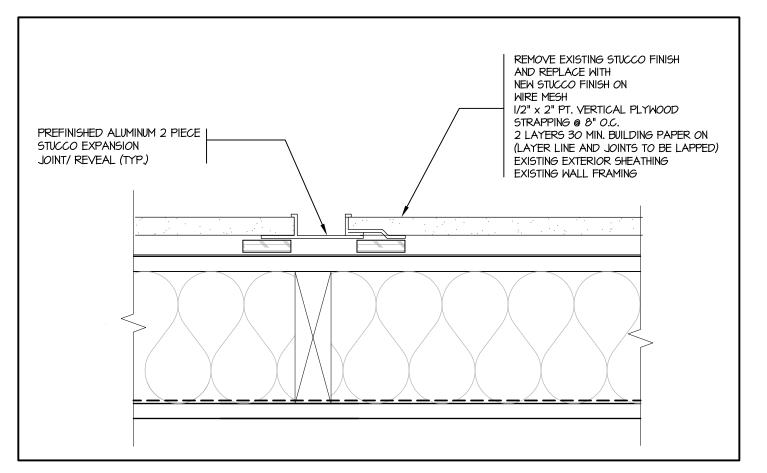

19 PLAN DETAIL @ STUCCO EXPANSION JOINT
A5 SCALE: 3" = 1'-0"

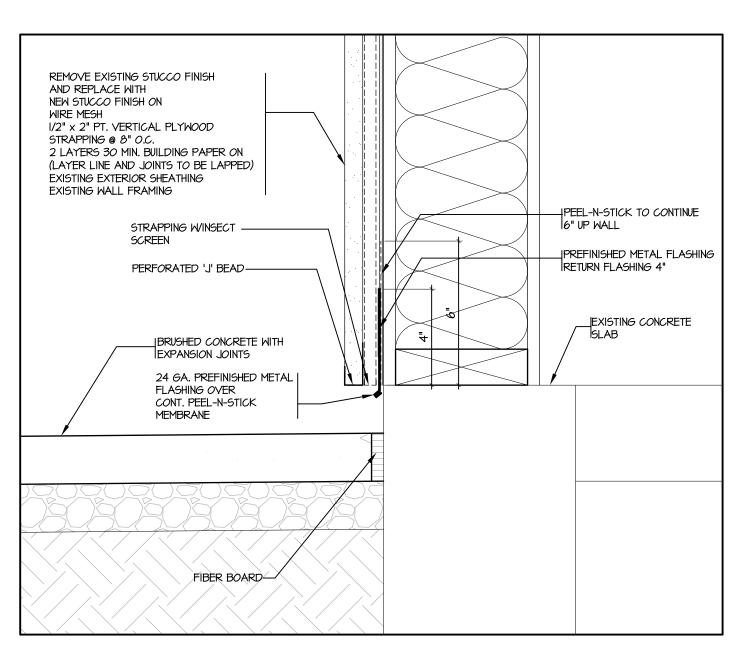

20 DETAIL @ BOTTOM OF NEW STUCCO
A5 SCALE: 3" = 1'-0"

APR. 2/13	ISSUED FOR CONSTRUCTION	
JAN. II/I3	ISSUED FOR TENDER	
DEC. 17/12	ISSUED FOR BUILDING PERMIT	
JULY 16/12	ISSUED FOR PPA	-
DATE	ISSUE	REV
CONSULTANT		

CONSULTANT SEAL

CONTRACTOR SHALL VERIFY ALL DIMENSIONS ON SITE. DRAWINGS SHALL NOT BE SCALED.



3707 1st AVENUE
BURNABY, BRITISH COLUMBIA
V5C 3V6 E-MAIL: pjlovick@pjlovick.com
tel: 604-298-3700 fax: 604-298-6081

Member of the AIBC Member of the SAA

Member of the AAA

Member of the RAIC

Certified Professional

ARCHITECT SEAL

Member of the NWTAA

COPYRIGHT P.J. LOVICK ARCHITECT LTD. THIS MATERIAL IS AN INSTRUMENT OF SERVICE AND REMAINS AT ALL TIMES THE EXCLUSIVE PROPERTY OF P.J. LOVICK ARCHITECT LTD. REPRODUCTION OR RE-USE IS PROHIBITED WITHOUT THE WRITTEN CONSENT AND NAME OF P.J. LOVICK ARCHITECT LTD. INFORMATION SHOWN IS FOR USE ON THE DESIGNATED PROJECT ONLY. DRAWN BY

PJL

## EXISTING BUILDING ALTERATION FOR VISIONS

5756 IMPERIAL STREET BURNABY, BC

\_\_\_\_

SECTION DETAILS

PROJECT NUMBER	DRAWING NUMBER
12-18	A14
SCALE  " =  '-O"	
DATE DEC 2012	REVISION